


T.6S. R.3W., W.M

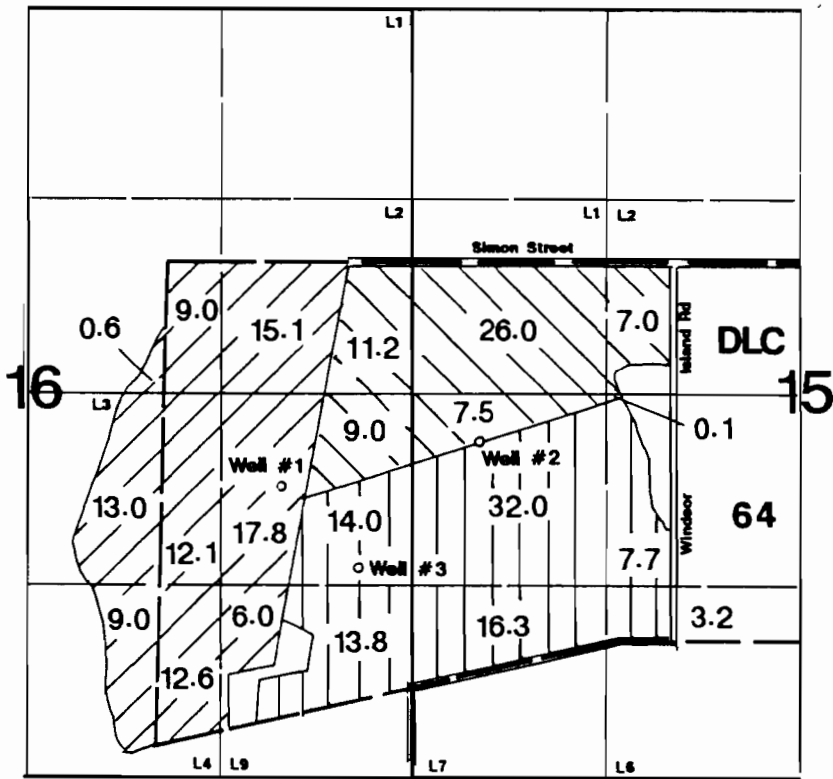

1" = 1320'



Well #3



Well #2



Well #1

Well #1 is located 600'S & 860'W
 Well #2 is located 330'S & 450'E ---all from the E1/4 corner of Section 16.
 Well #3 is located 1200'S & 350'W

Final Proof Survey

Application #: G-12734 Permit #: G-11957

In Name Of

Capitol Farms

Surveyed on August 28, 1999 by JM Schuette

RECEIVED

SEP 24 1999

**WATER RESOURCES DEPT
 SALEM, OREGON**

This Map Was Prepared For The Purpose Of Identifying The Location Of A Water Right Only And Is Not Intended To Provide Legal Dimensions Or Location Of Property Ownership Lines.

