


SECTION 16, TWP.2 S. RANGE 14 E. W.M.
WASCO COUNTY, OREGON

RECEIVED

SEP 30 1999

WATER RESOURCES DEPT
SALEM, OREGON

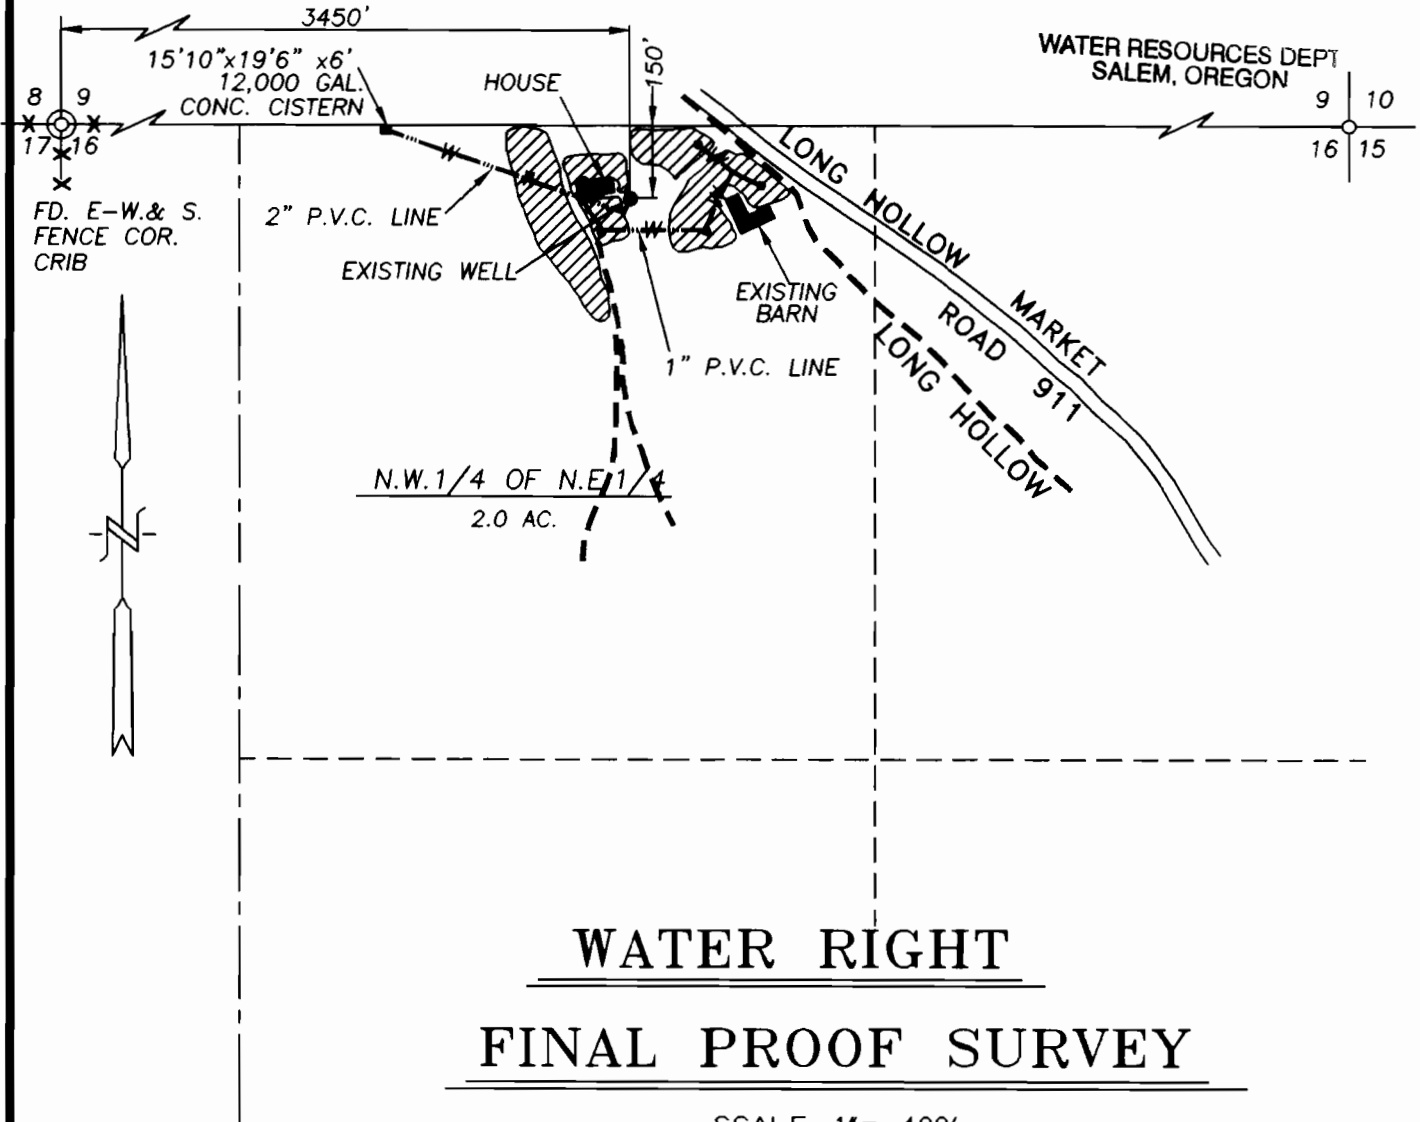

WATER RIGHT
FINAL PROOF SURVEY

SCALE: 1" = 400'


APPLICATION No. G-13165

PERMIT No. G-11960

IN THE NAME OF:

MARTIN ARTHUR UNDERHILL

DATE: SEPTEMBER 28, 1999

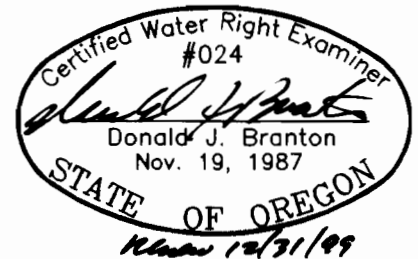

NOTE:

"THIS MAP IDENTIFIES THE LOCATION OF THE WATER RIGHT ONLY AND IS NOT INTENDED TO PROVIDE DIMENSIONS OR LOCATE PROPERTY OWNERSHIP LINES."

BY: TENNESON ENGINEERING CORP.
409 LINCOLN STREET,
THE DALLES, OREGON. 97058
PH. 541-296-9177
FAX 541-296-6657