

JUL 31 2000



TRANSFER NO. T- 7607

IN NAME OF

NO. 9-112,175


Certified Water Right Examiner
229WRE

Larry W. Jebousek

Larry W. Jebousek
Dec 7, 1989
STATE OF OREGON

Surveyed JULY 19, 2000,, **by**

T. 6 S. R. 2 W., W.M.

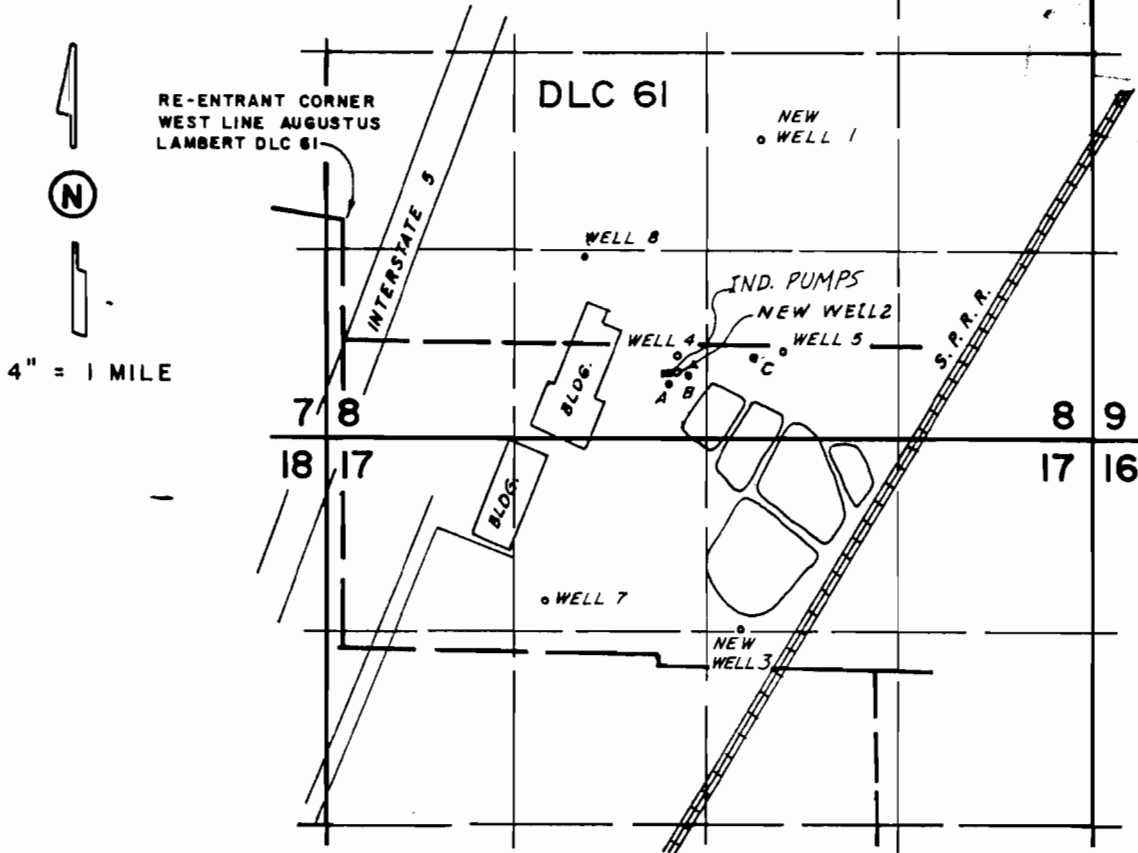

WELL LOC. FROM RE-ENTRANT CORNER,
WEST LINE, AUGUSTUS LAMBERT DLC 61:

NEW NO. 3 2840' S. & 2710' E.
NEW NO. 2 1050' S. & 2280' E.
NEW NO. 1 570' N. & 2850' E.
NO. 4 920' S. & 2280' E.
NO. 5 890' S. & 2990' E.
NO. 6 2380' N. & 3930' E.
NO. 7 2640' S. & 1390' E.
NO. 8 210' S. & 1680' E.

WELL FIELD & INDUSTRIAL USE

FINAL PROOF SURVEY UNDER

'A' OLD WELL NO. 1
(ABANDONED)

'B' OLD WELL NO. 3
(ABANDONED)

'C' OLD WELL NO. 2
(ABANDONED)

Application No. G-12498 Permit No. G-11974
IN NAME OF

NORPAC FOODS, INC.

THIS MAP WAS PREPARED FOR THE
PURPOSE OF IDENTIFYING THE LOCA-
TION OF A WATER RIGHT ONLY AND IS
NOT INTENDED TO PROVIDE LEGAL
DIMENSIONS OR LOCATION OF PROPER-
TY OWNERSHIP LINES.

Surveyed JULY 19, 2000, by

