


# Township 6 South, Range 1 West, W.M.

Portions of Sections 2 & 11

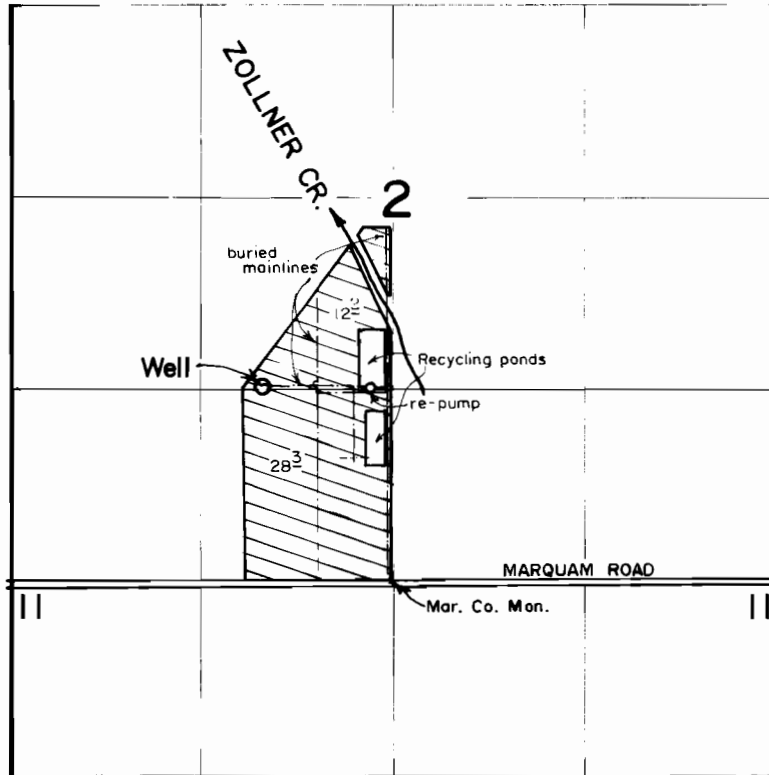

WELL LOCATED 1360' N. and 910' W. FROM S. 1/4 COR. SEC. 2.

## FINAL PROOF SURVEY


under

Appl. No. G-12527, Per. No. G-11975

in name of

KRAEMER'S NURSERY, INC.

Jun. 13, 1996

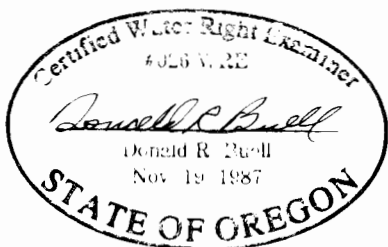

THIS MAP WAS PREPARED FOR THE PURPOSE OF IDENTIFYING THE LOCATION OF A WATER RIGHT ONLY AND IS NOT INTENDED TO PROVIDE LEGAL DIMENSIONS OR LOCATION OF PROPERTY OWNERSHIP LINES.