


RECEIVED

DEC 31 1997

WATER RESOURCES DEPT
SAI FM, OREGON

T.5S. R.1W. W.M.

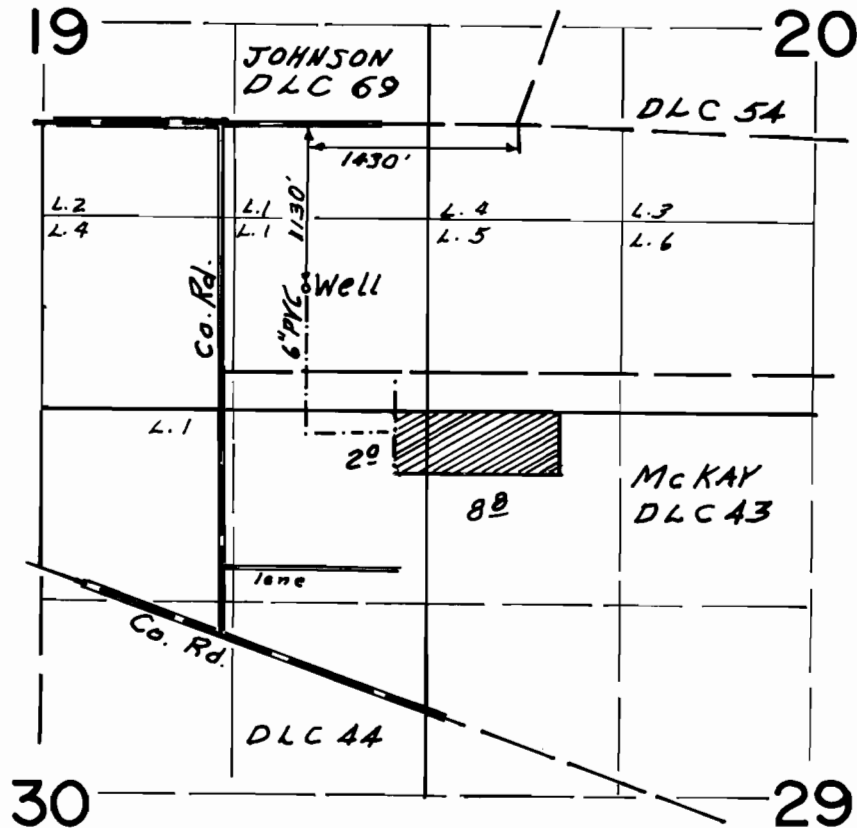


Scale
4" = 1 Mi.

FINAL PROOF SURVEY UNDER

Application No. ~~G-12102~~ Permit No. ~~G-11982...~~
IN NAME OF

DAVID..OBERSINNER.....

Surveyed Aug. 13, 1997., by

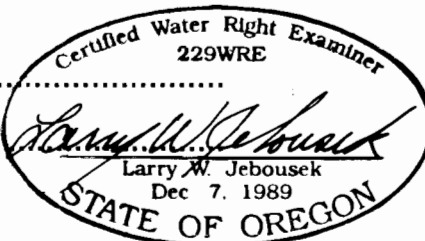

THIS MAP WAS PREPARED FOR THE PURPOSE OF IDENTIFYING THE LOCATION OF A WATER RIGHT ONLY AND IS NOT INTENDED TO PROVIDE LEGAL DIMENSIONS OR LOCATION OF PROPERTY OWNERSHIP LINES.