


Nursery Operations

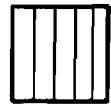


Primary



Supplemental

Well located 100'S & 1290'W from the center of Section 8.

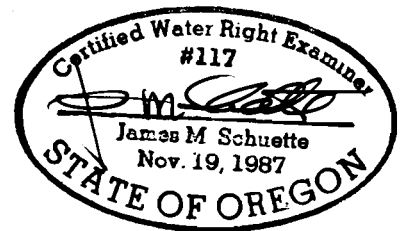

Final Proof Survey

Application #: G-12384 Permit #: G-11994

In Name Of

Sid Miles

Surveyed on January 30, 1996 by JM Schuette

RECEIVED

FEB 14 1996

WATER RESOURCES DEPT.
SALEM, OREGON

THIS MAP WAS PREPARED FOR THE PURPOSE OF IDENTIFYING THE LOCATION OF A WATER RIGHT ONLY AND IS NOT INTENDED TO PROVIDE LEGAL DIMENSIONS OR LOCATION OF PROPERTY OWNERSHIP LINES.