


# T.7S. R.1W., W.M

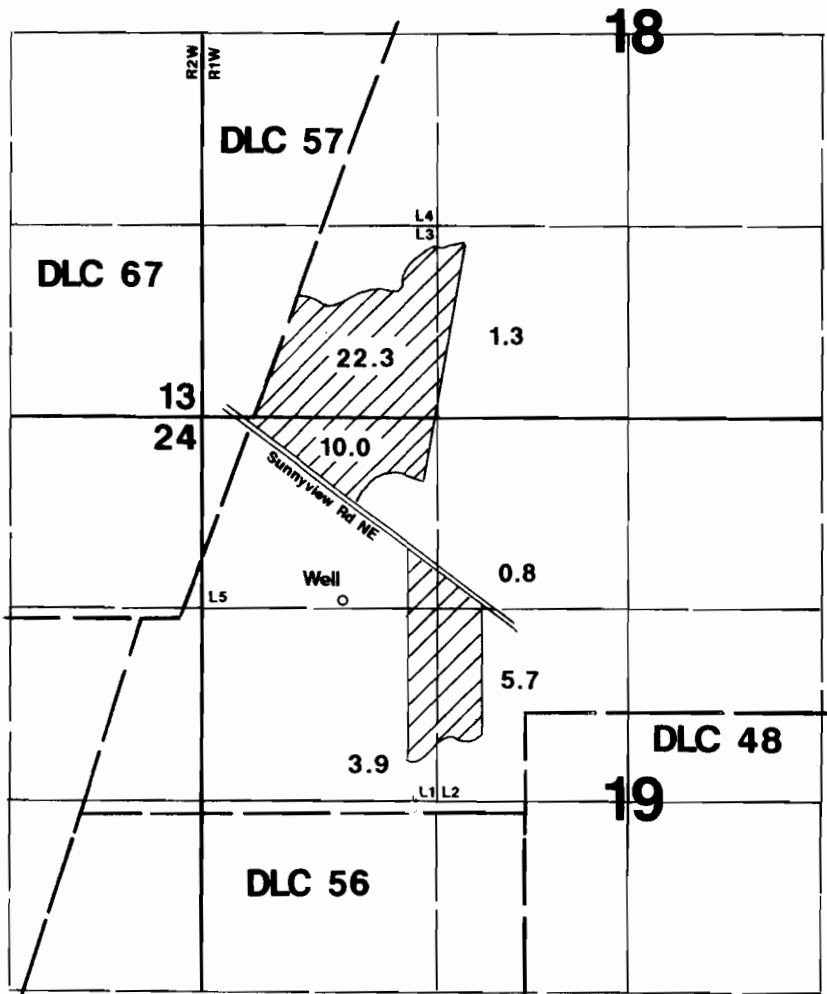

Well is located 1460'N & 1270'W from the NE corner of DLC 56.

## Final Proof Survey

Application #: G-12845      Permit #: G-12006

In Name Of

### Donald W. Mantie

Surveyed on February 26, 1999 by JM Schuette

This Map Was Prepared For The Purpose Of Identifying The Location Of A Water Right Only And Is Not Intended To Provide Legal Dimensions Or Location Of Property Ownership Lines.

RECEIVED  
MAR 23 1999  
WATER RESOURCES DEPT  
SALEM, OREGON

