


RECEIVED

# T.3S. R.3W., W.M

OCT 01 1998

RESOURCES DEPT  
SALEM, OREGON

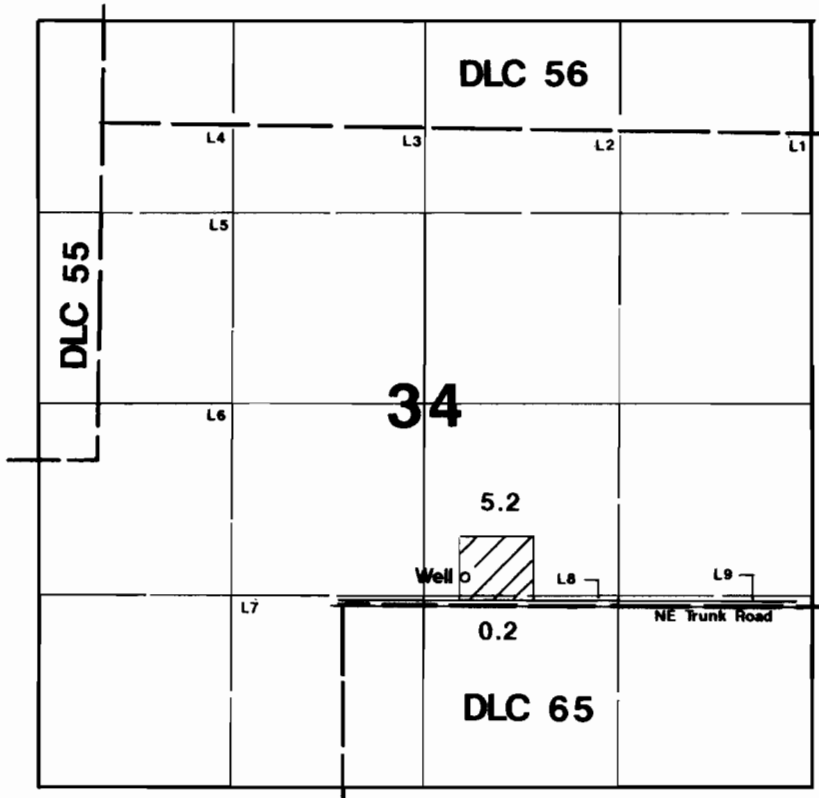

Well is located 165'N & 840'E from the NW corner of DLC 65.

## Final Proof Survey

Application #: G-13222    Permit #: G-12020

In Name Of

# Thomas & Ellen Abrego

Surveyed on September 29, 1998 by JM Schuette

This Map Was Prepared For The Purpose Of Identifying The Location Of A Water Right Only And Is Not Intended To Provide Legal Dimensions Or Location Of Property Ownership Lines.

