


RECEIVED

AUG 30 1995

WATER RESOURCES DEPT.
SALEM, OREGON

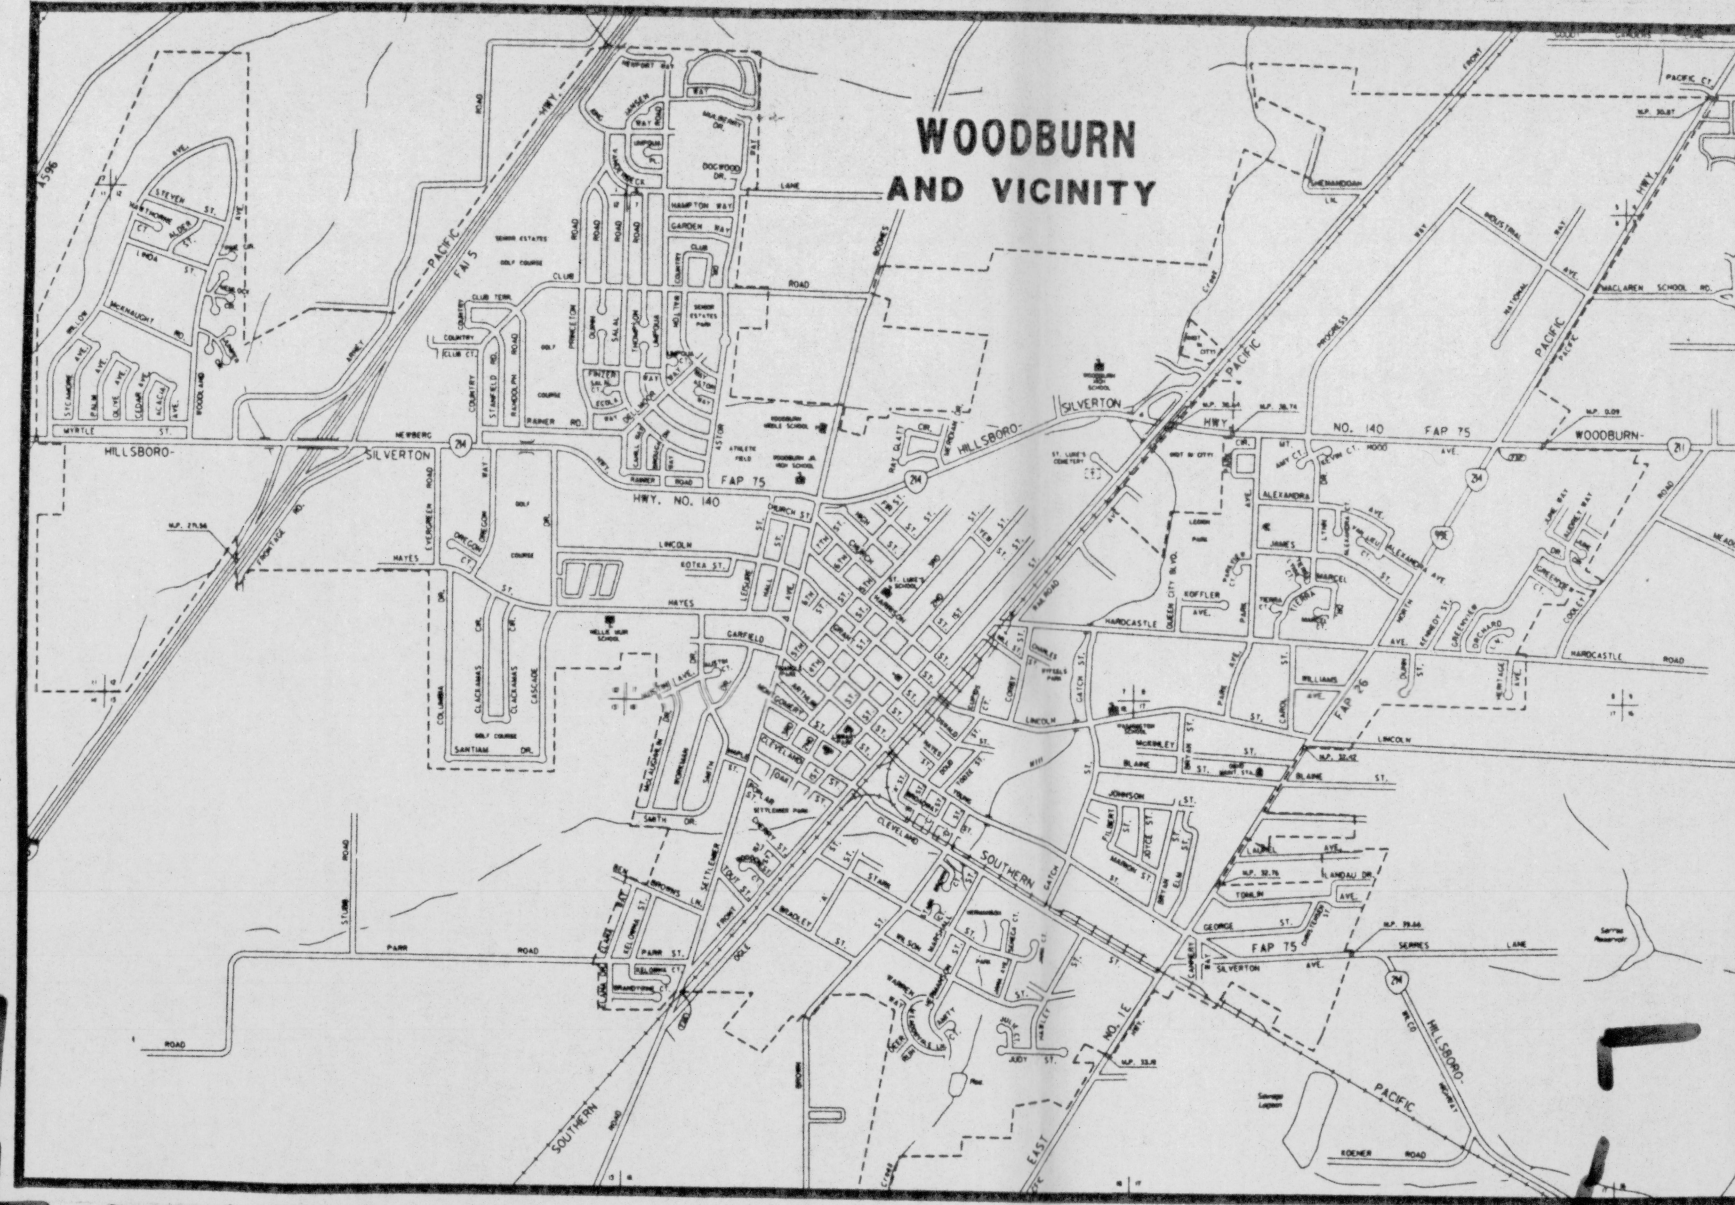

R2W R1W



NORTH
SCALE: 1" = 600'


CITY OF WOODBURN

Beneficial Use Map

The Astor Way Well (point of diversion) is located 1840' S and 920' E of the NW Corner of Section 7, in the SW 1/4 of the NW 1/4 of Section 7, T5S, R1W, W.M.

The purpose of this Map is to identify the location of the Water Right. The Map or Dimensions is not intended to provide information relative to the location of property ownership lines.

- 1" WATER LINE
- 4" WATER LINE
- 6" WATER LINE
- 10" WATER LINE
- 12" AND UP WATER LINE
- CITY LIMIT LINE
- URBAN GROWTH BOUNDARY
- CURRENT WATER WELLS
- LIMITS OF BENEFICIAL USE

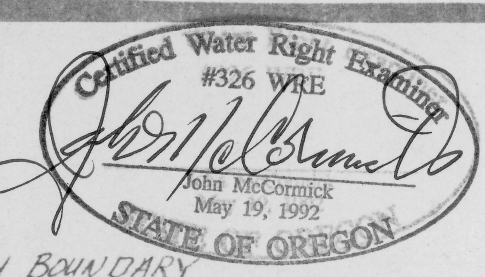

DATE OF SURVEY/INSPECTION AUGUST 7, 1995

R2W R1W