

FINAL PROOF SURVEY

APPLICATION No. G-12595

PERMIT No. G-12044



Applicant: Warner & Mary Kay Maag
5234 Hill Road
Vale, OR 97918



RECEIVED

OCT 01 1999

WATER RESOURCES DEPT
SALEM, OREGON

SCALE: 1" = 1320'

T16S R43E

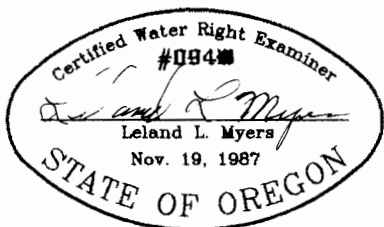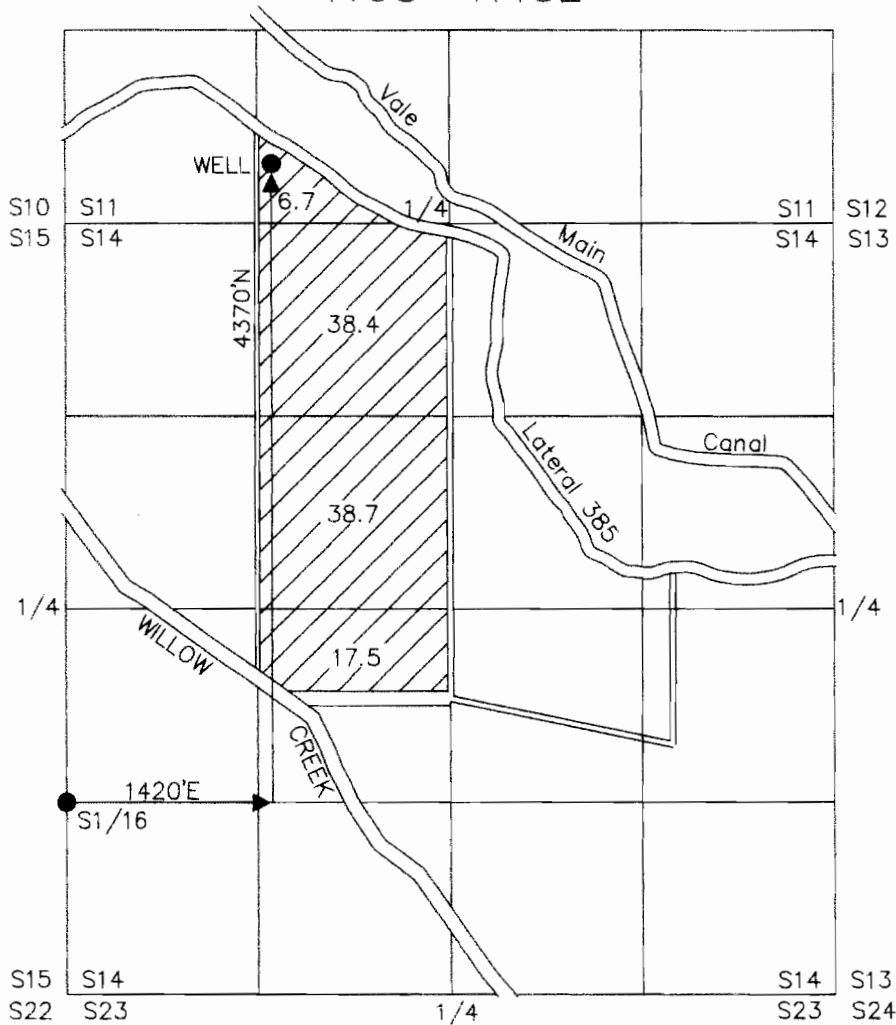

This map is for the purpose of identifying the location of the water right only and has no intent to provide dimensions or location of property ownership lines.