


TOWNSHIP 14 SOUTH, RANGE 16 EAST, W.M.
SE 1/4 SE 1/4, Section 30

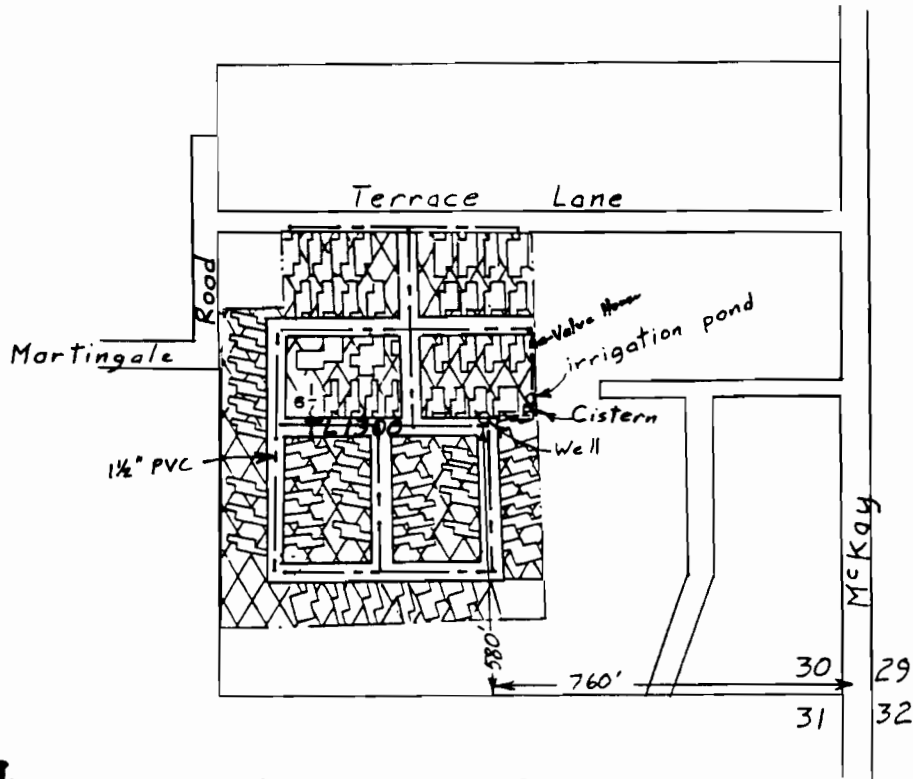

Scale 1" = 400'

RECEIVED


SEP 24 1999

**LAND RESOURCES DEPT.
SALEM, OREGON**

Surveyed April 2, 1999

Claim of Beneficial Use Map
for
TERRACE MOBILE PLAZA

App G-12782
Per G-12046

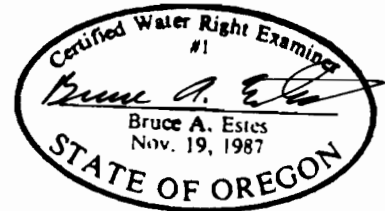

This map is for the purpose of locating a water right only and has no intent to provide legal dimensions or the location of property lines.

ESTES SURVEYS

6293 Sunnyview Rd. NE Salem, OR 97305 (503) 585-7593
60382 Arnold Rd. Bend, OR 97702 (503) 382-7391