

SW 1/4 & SE 1/4 OF THE NE 1/4 OF SECTION 20
 NW 1/4 OF THE SE 1/4 OF SECTION 20 OF
 T2S & R1E OF WM, CLACKAMAS COUNTY, OREGON

WELL #2 IS LOCATED 1085' WEST & 590' NORTH OF
 THE SE 1/4 CORNER OF THE NE QUARTER OF SECTION 20
 SAID WELL IS LOCATED IN THE SOUTHEAST 1/4 OF THE
 NORTHEAST 1/4 OF SECTION 20, TOWNSHIP 2 SOUTH,
 RANGE 1 EAST OF THE WM, CLACKAMAS CO. OREGON

PREPARATION OF THIS MAP WAS FOR THE
 PURPOSE OF IDENTIFYING THE LOCATION
 OF THE WATER RIGHTS ONLY AND HAS
 NO INTENT TO PROVIDE DIMENSIONS OR
 LOCATION OF PROPERTY OWNERSHIP LINES

SW 1/4 OF NE 1/4
 AREA = 3.63 ACRES TOTAL
 IRRIGATED AREA = 3.63 AC

6" BUTTERFLY VALVE
 SYPHON BRKR TEE
 12" ALUM CMP CULV
 6" PVC SYPHON LINE
 55 GAL DRUM

MAP 2, 1E 20AC
 TAX LOT 200
 TOTAL = 4.83 AC

MAP 2, 1E 20AD
 TAX LOT 1300
 TOTAL = 7.62 ACRES

SW 1/4 OF NE 1/4
 NW 1/4 OF SE 1/4

SE 1/4 OF NE 1/4
 NE 1/4 OF SE 1/4



NW 1/4 OF SE 1/4
 AREA = 1.20 ACRES TOTAL
 IRRIGATED AREA = 1.20 AC

ASSESSOR MAP 25 3E 2C
 DAMASCUS 7.5' QUAD

FINAL PROOF SURVEY
 GROUNDWATER PERMIT G-12053

PREPARED BY EDWARD A. CRANE, CWRE

TUALATIN RIVER

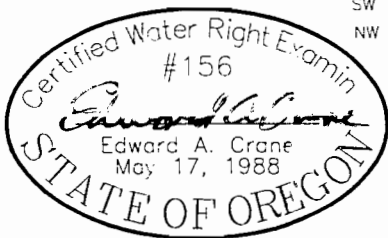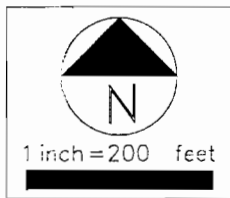

Renewal 12/31/99

Signed 3-18-99

SURVEYED FEBRUARY 22, 1999
 BY EDWARD A. CRANE, CWRE

K:\CAD\319-002\319-002.DWG EAC 3/18/99

DATE
 MAR. 1999
 PROJECT NO.
 319-002



CRANE & MERSEITH
 Engineering/Surveying
 SUITE "D"
 6566 SE LAKE ROAD
 MILWAUKIE, OREGON 97222
 BUS: (503) 654-2005
 FAX: (503) 654-2575

APPLICATION FOR PERMIT NUMBER G-13560
 PERMIT NUMBER G-12053 IN THE NAME OF:
 DON & GAIL RIGBY, TEL: 503-638-3030
 3030 SW CHILDS RD, LAKE OSWEGO, OR 97034
 GROUND WATER FINAL PROOF SURVEY

SHEET
 1/1