

FINAL PROOF SURVEY
PERMIT G-12069

Sheet 1 of 2


FROM
V 1/2

TO
V 1/2

T.6N., R.35E., W.M.


SEC. 22

SEC. 22

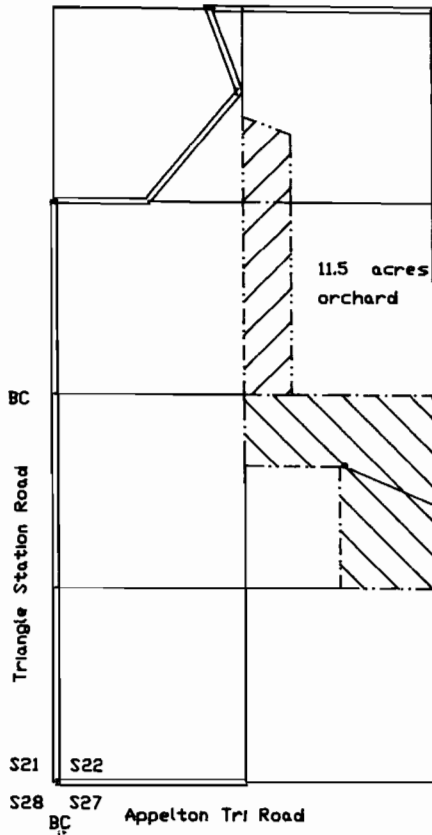

Permit G-12069
Application G-13784

Final Proof Survey
November 4, 1997

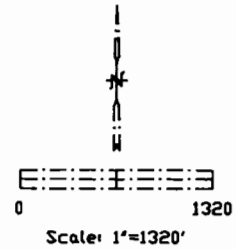

11.5 acres
orchard

11.5 acres orchard
Secondary Use Well
Primary Use - Permit 41229


See Sheet 2 of 2
for details on
application system.

27.2 acres
orchard

Well located
2065' East and
466' South of
West 1/4 corner
Sections 21 and 22.

20.0 acres orchard
Primary Use Well


Well located
2065' East and
466' South of
West 1/4 corner
Sections 21 and 22.

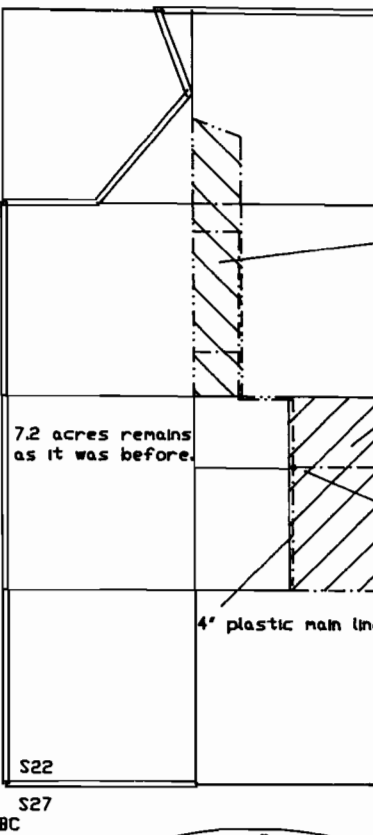

4" plastic main line

OWNER:
Mr. Ronald Haney
85141 Triangle Station Road
Milton-Freewater, OR 97862
(541) 558-3644

Survey By:
CWRE 300
(renews 6-30-99)
David Haddock
P. O. Box 1574
Pendleton, OR 97801
(541) 276-2174
Survey - July 1994
Revised November 1997

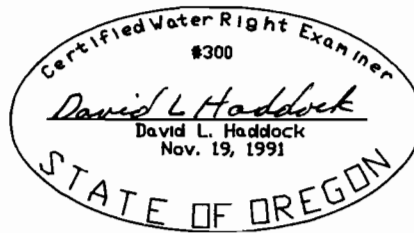

NOTE:
The information shown
on this map is solely
for Water Rights
purposes. The data
shown does not represent
ownership information.

WATER RESOURCES DEPT.
SALEM, OREGON


NOV 14 1997

RECORDED


RECORDED

NOV 14 1997


WATER RESOURCES DEPT
SALEM, OREGON

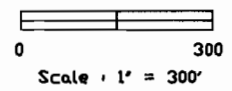

3.5 acres
12 lines at 27.8 foot spacing
1/3 length of each line 2" plastic pipe
1/3 of each line 1.5" plastic pipe
1/3 of each line 1" plastic pipe

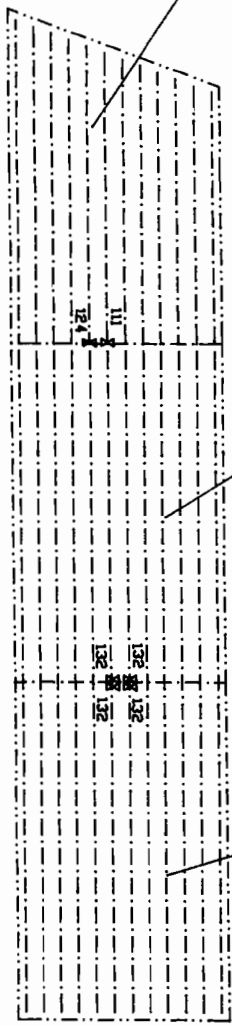

8.0 acres
23 lines at 27.2 foot spacing
1/3 length of each line 2" plastic pipe
1/3 of each line 1.5" plastic pipe
1/3 of each line 1" plastic pipe

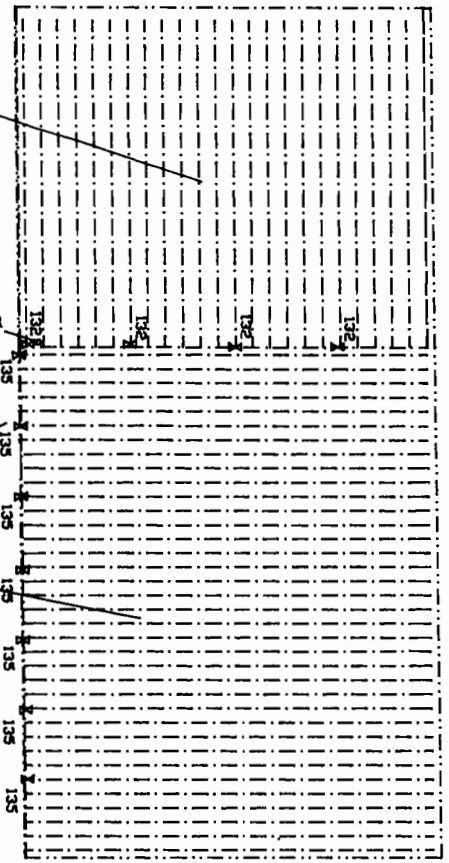

4.0 acres
12 lines at 27.8 foot spacing
1/3 length of each line 2" plastic pipe
1/3 of each line 1.5" plastic pipe
1/3 of each line 1" plastic pipe

10.0 acres
35 lines at 22.1 foot spacing
1/3 length of each line 2" plastic pipe
1/3 of each line 1.5" plastic pipe
1/3 of each line 1" plastic pipe

4.0 acres
12 lines at 27.8 foot spacing
1/3 length of each line 2" plastic pipe
1/3 of each line 1.5" plastic pipe
1/3 of each line 1" plastic pipe

OWNER:
Mr. Ronald Haney
85141 Triangle Station Road
Milton-Freewater, OR 97862
(541) 558-3644

Survey By:
CWRE 300
(renews 6-30-99)
David Haddock
P. O. Box 1574
Pendleton, OR 97801
(541)276-2174
Survey - July 1994
Revised November 1997

