


TOWNSHIP 2 SOUTH, RANGE 1 WEST, W.M.  
Section 21

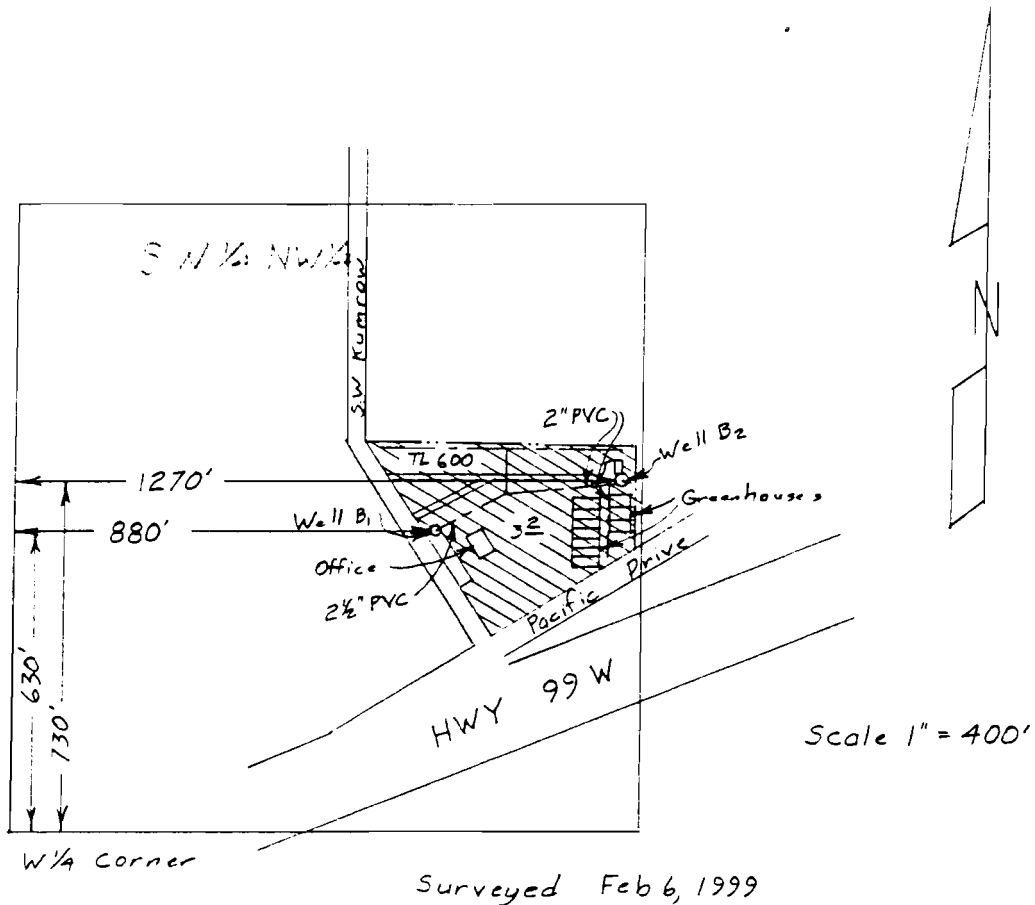


Claim of Beneficial Use Map  
for  
LOEN NURSERY CO.

**RECEIVED**

**OCT 11 1999**

... SALES DEPT.  
SALEM, OREGON

App G-12495  
Per G-12073  
& T-7827

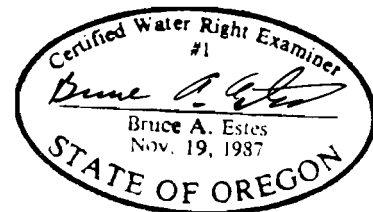

Renewal Dec 31, 1999

This map is for the purpose of  
locating a water right only  
and has no intent to provide  
legal dimensions or the location  
of property lines.

**ESTES SURVEYS**

6293 Sunnyview Rd. NE Salem, OR 97305 (503) 585-7593  
60382 Arnold Rd. Bend, OR 97702 (503) 382-7391