
## T.6S., R.2W., W.M.

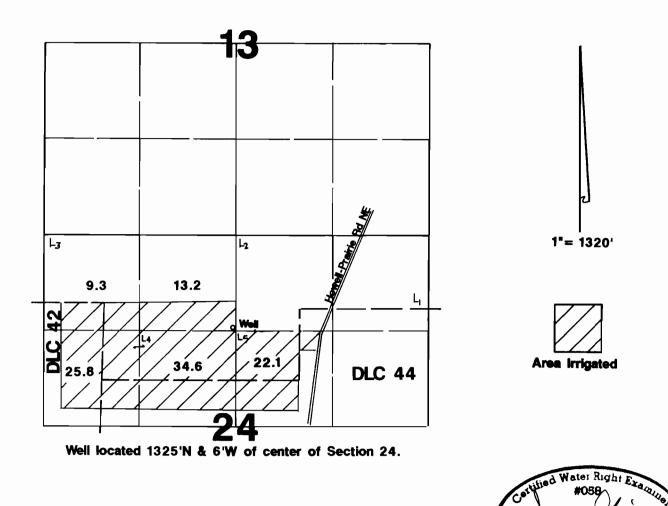

## **Final Proof Survey**

James Grimm Nov. 19, 1987

Application #: G-13161 Permit #: G-12083

In Name Of

## Clarence Schmidt

Surveyed on June 12, 1996 by James Grimm