



Township 6 South, Range 1 West, W.M.
Portions of Sections 1 & 2

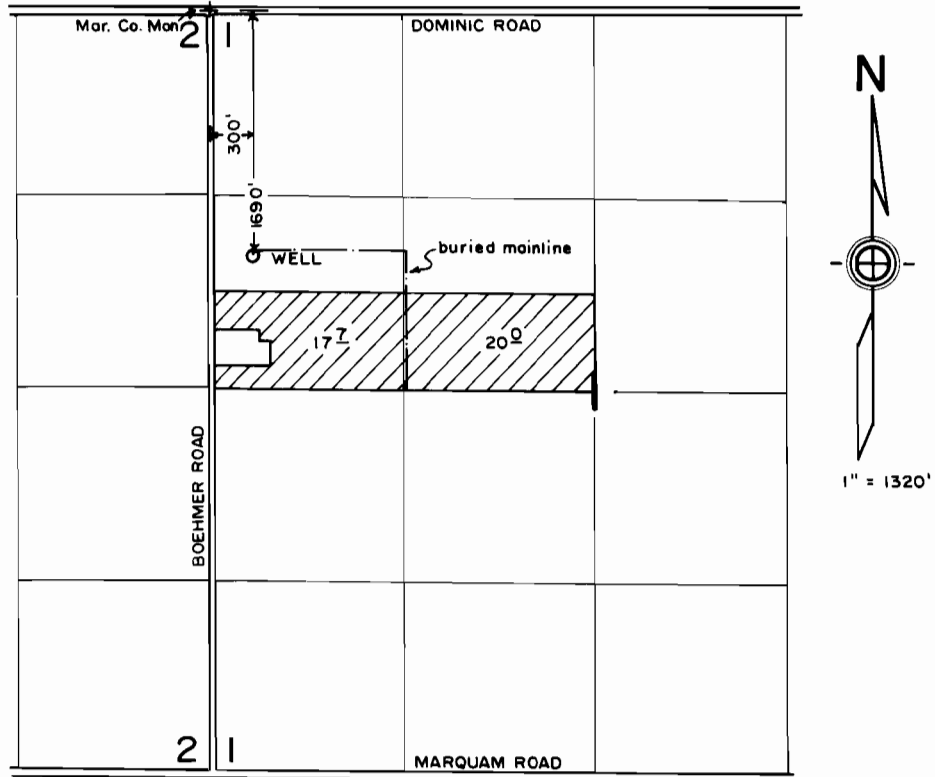

FINAL PROOF SURVEY
under
Appl. No. G-13306, Per. No. G-12087
in name of
DAN HAMMELMAN
Oct. 22, 1997

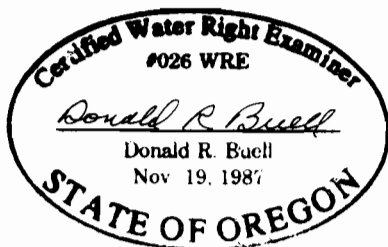

THIS MAP WAS PREPARED FOR THE PURPOSE OF IDENTIFYING THE LOCATION OF A WATER RIGHT ONLY AND IS NOT INTENDED TO PROVIDE LEGAL DIMENSIONS OR LOCATION OF PROPERTY OWNERSHIP LINES