


T. 9S R. 40E., W.M.

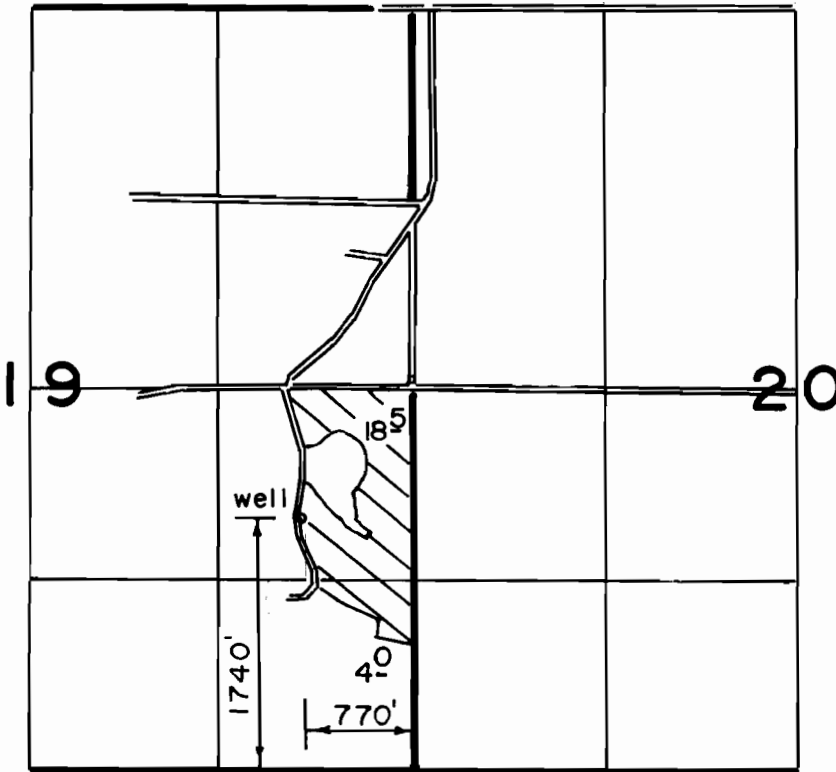

SCALE 1" = 1320'

THE PURPOSE OF THIS MAP IS FOR IDENTIFYING THE LOCATION OF THE WATER RIGHT ONLY AND IS NOT INTENDED TO PROVIDE LEGAL DIMENSIONS OF PROPERTY OWNERSHIP LINES.

# FINAL PROOF SURVEY

UNDER

APPL. G-13418

PER. G-12088

IN NAME OF

ROBERT P. ELLINGSON III

Surveyed June 2, 1999

RECEIVED

SEP 30 1999

WATER RESOURCES DEPT.  
SALEM, OREGON