


THIS MAP WAS PREPARED FOR THE PURPOSE OF IDENTIFYING THE LOCATION OF THE WATER RIGHT AND IS NOT INTENDED TO PROVIDE LEGAL DIMENSIONS OR LOCATIONS OF PROPERTY OWNERSHIP LINES.

T21S; R3E

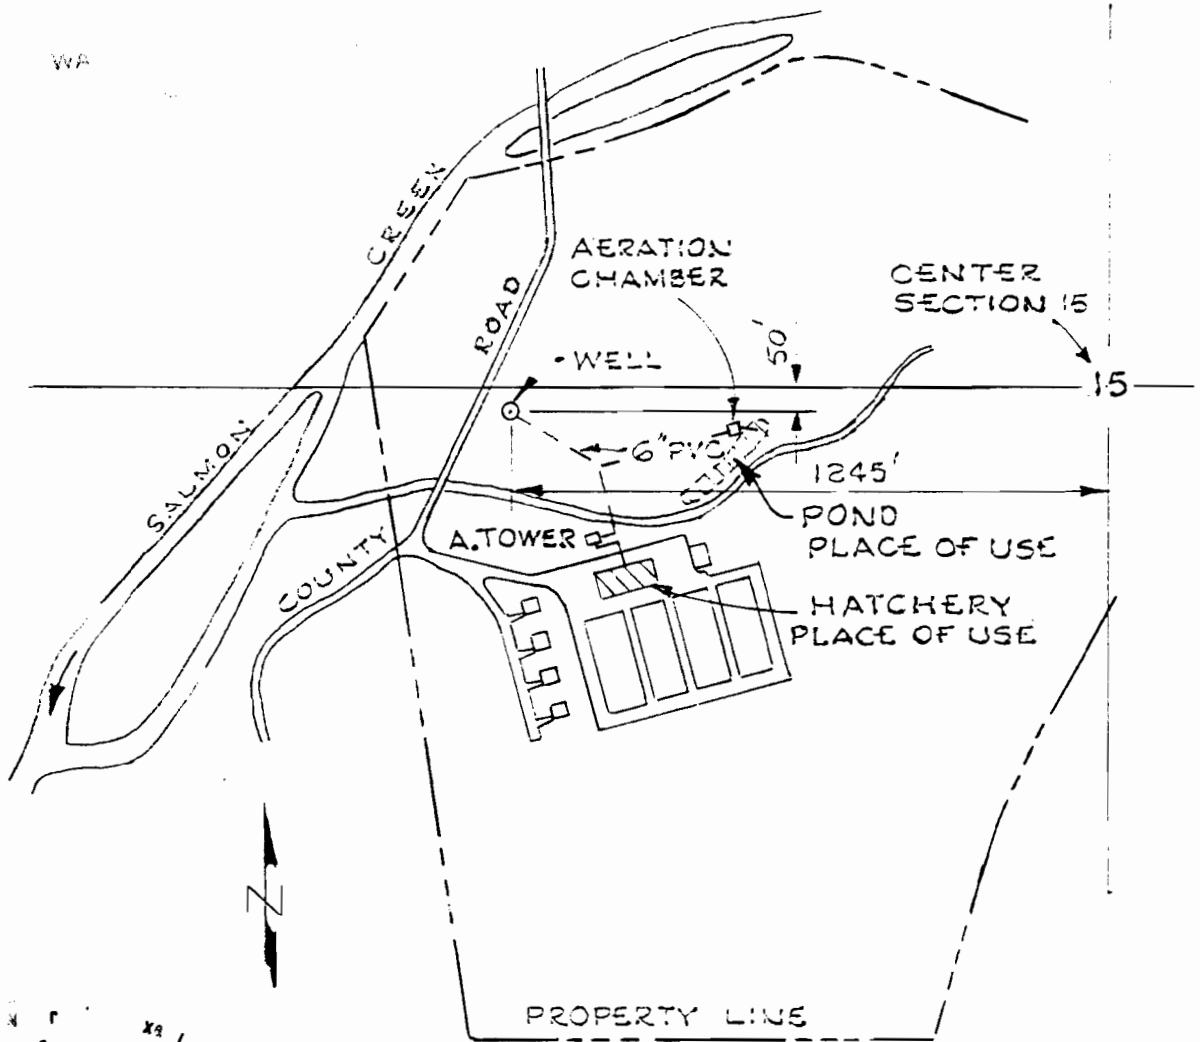

SCALE: 1" = 400'

Robert O. Dodge
ROB
STA E O P L C

FINAL PROOF SURVEY UNDER

APPLICATION NO. G-13755 PERMIT NO. G-12109
IN NAME OF

OREGON DEPARTMENT OF FISH AND WILDLIFE

SURVEYED: 7/9/96 BY: DODGE