
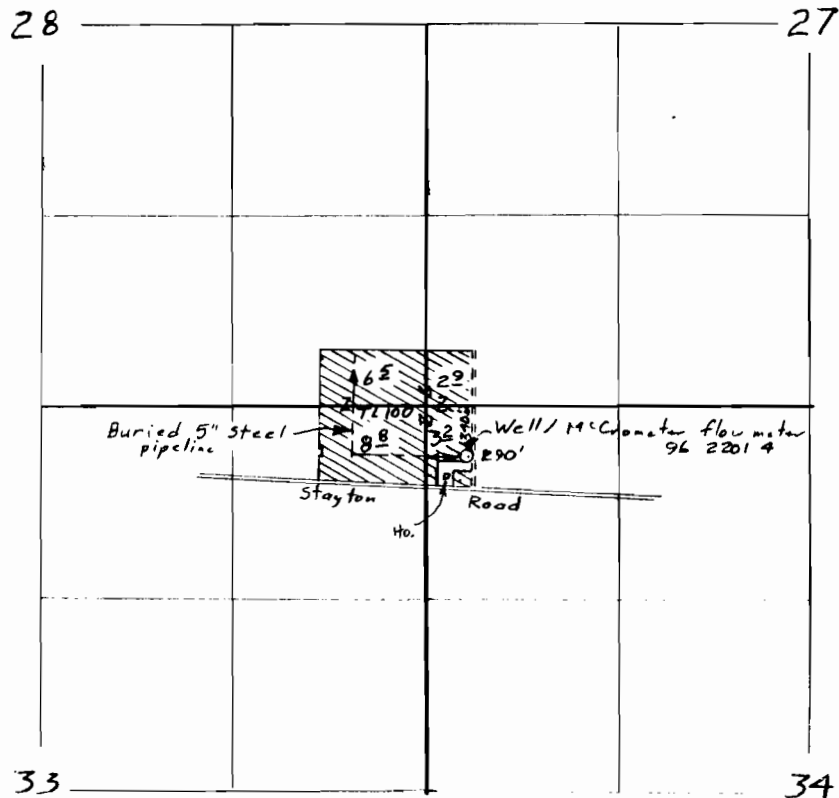



TOWNSHIP 9 SOUTH, RANGE 2 WEST, W.M.

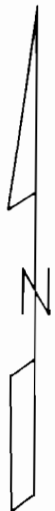

Scale 1" = 1320'

Surveyed Oct. 8, 1997

Claim of Beneficial Use Map
for
GAROLD & BONNIE MORRISSETTE

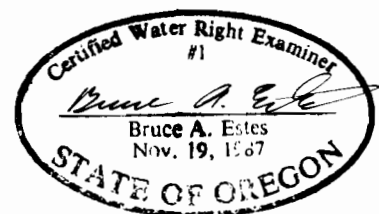

Application G-13803
Permit G-12130

RECEIVED

OCT 27 1997

WATER RESOURCES DEPT.
SALEM, OREGON

This map is for the purpose of
locating a water right only
and has no intent to provide
legal dimensions or the location
of property lines.

ESTES SURVEYS

6293 Sunnyview Rd. NE 60382 Arnold Rd.
Salem, OR 97305 Bend, OR 97702
(503) 585-7593 (503) 382-7391