



THIS MAP WAS PREPARED FOR THE PURPOSE OF IDENTIFYING THE LOCATION OF THE WATER RIGHT AND IS NOT INTENDED TO PROVIDE LEGAL DIMENSIONS OR LOCATIONS OF PROPERTY OWNERSHIP LINES.

T11S; R5W; W.M.

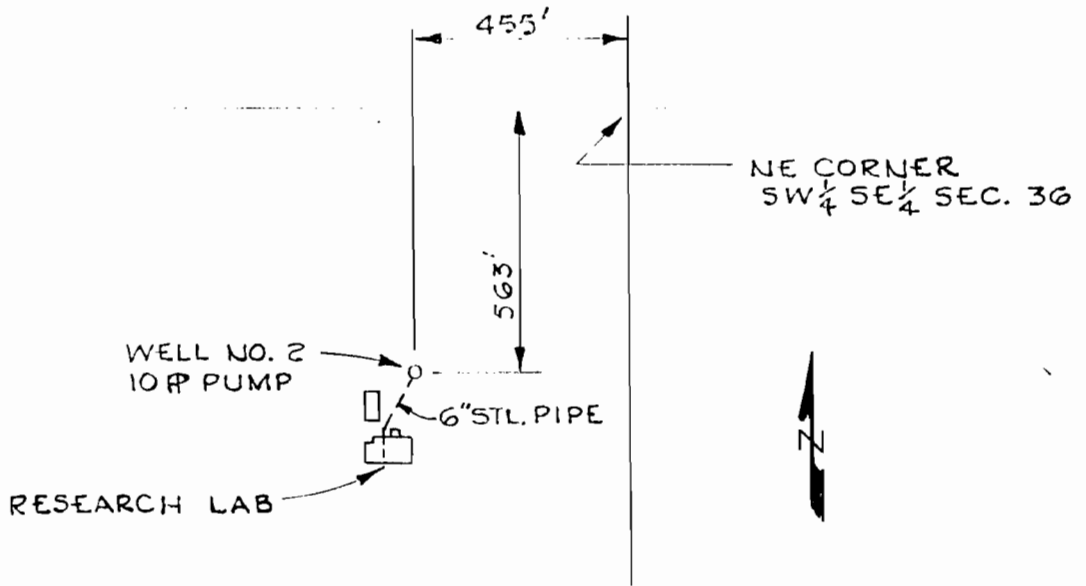

SCALE 1" = 400'

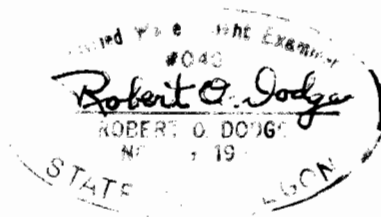

**FINAL PROOF SURVEY
UNDER**

APPLICATION NO. G-12389 PERMIT NO. 12131

IN NAME OF

OREGON DEPARTMENT OF FISH AND WILDLIFE

SURVEYED: 2/11/97

BY: DODGE