

RECEIVED


T. 3N., R. 29E., W.M.

SEP 30 1999

UMATILLA COUNTY

WATER RESOURCES DEPT
SALEM, OREGON

SCALE 1" = 1320'

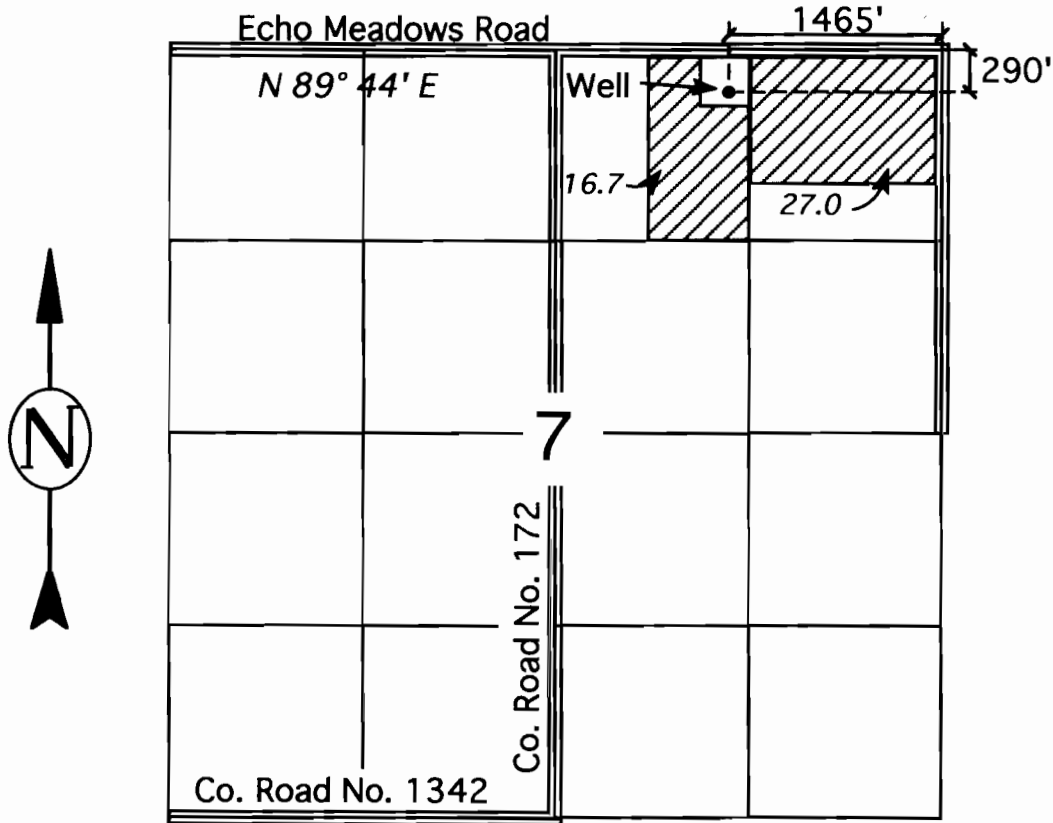

Well Located 290 Ft. South & 1465 Ft. West from the Northeast Corner of Section 7


WATER RIGHTS PROOF MAP

 Supplemental Water Rights Found at This Location

IN NAME OF

Wendell Lampkins

THIS MAP IS FOR THE PURPOSE
OF IDENTIFYING THE LOCATION
OF WATER RIGHTS ONLY AND IS
NOT INTENDED TO PROVIDE THE
LEGAL DIMENSIONS OR LOCATIONS
OF PROPERTY OWNERSHIP LINES.

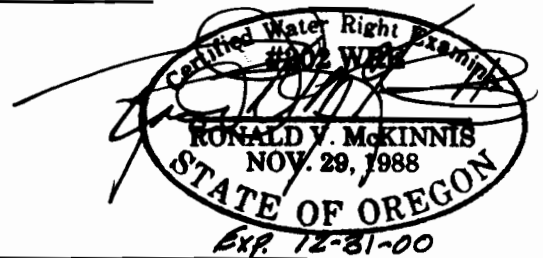

ENGINEERING - LAND SURVEYING - WATER RIGHTS
R. V. McKINNIS ENGINEERING
 79980 Prindle Loop Road
 Hermiston, Oregon 97838
 (541) -567-2017