T.8S., R.4W., W.M.

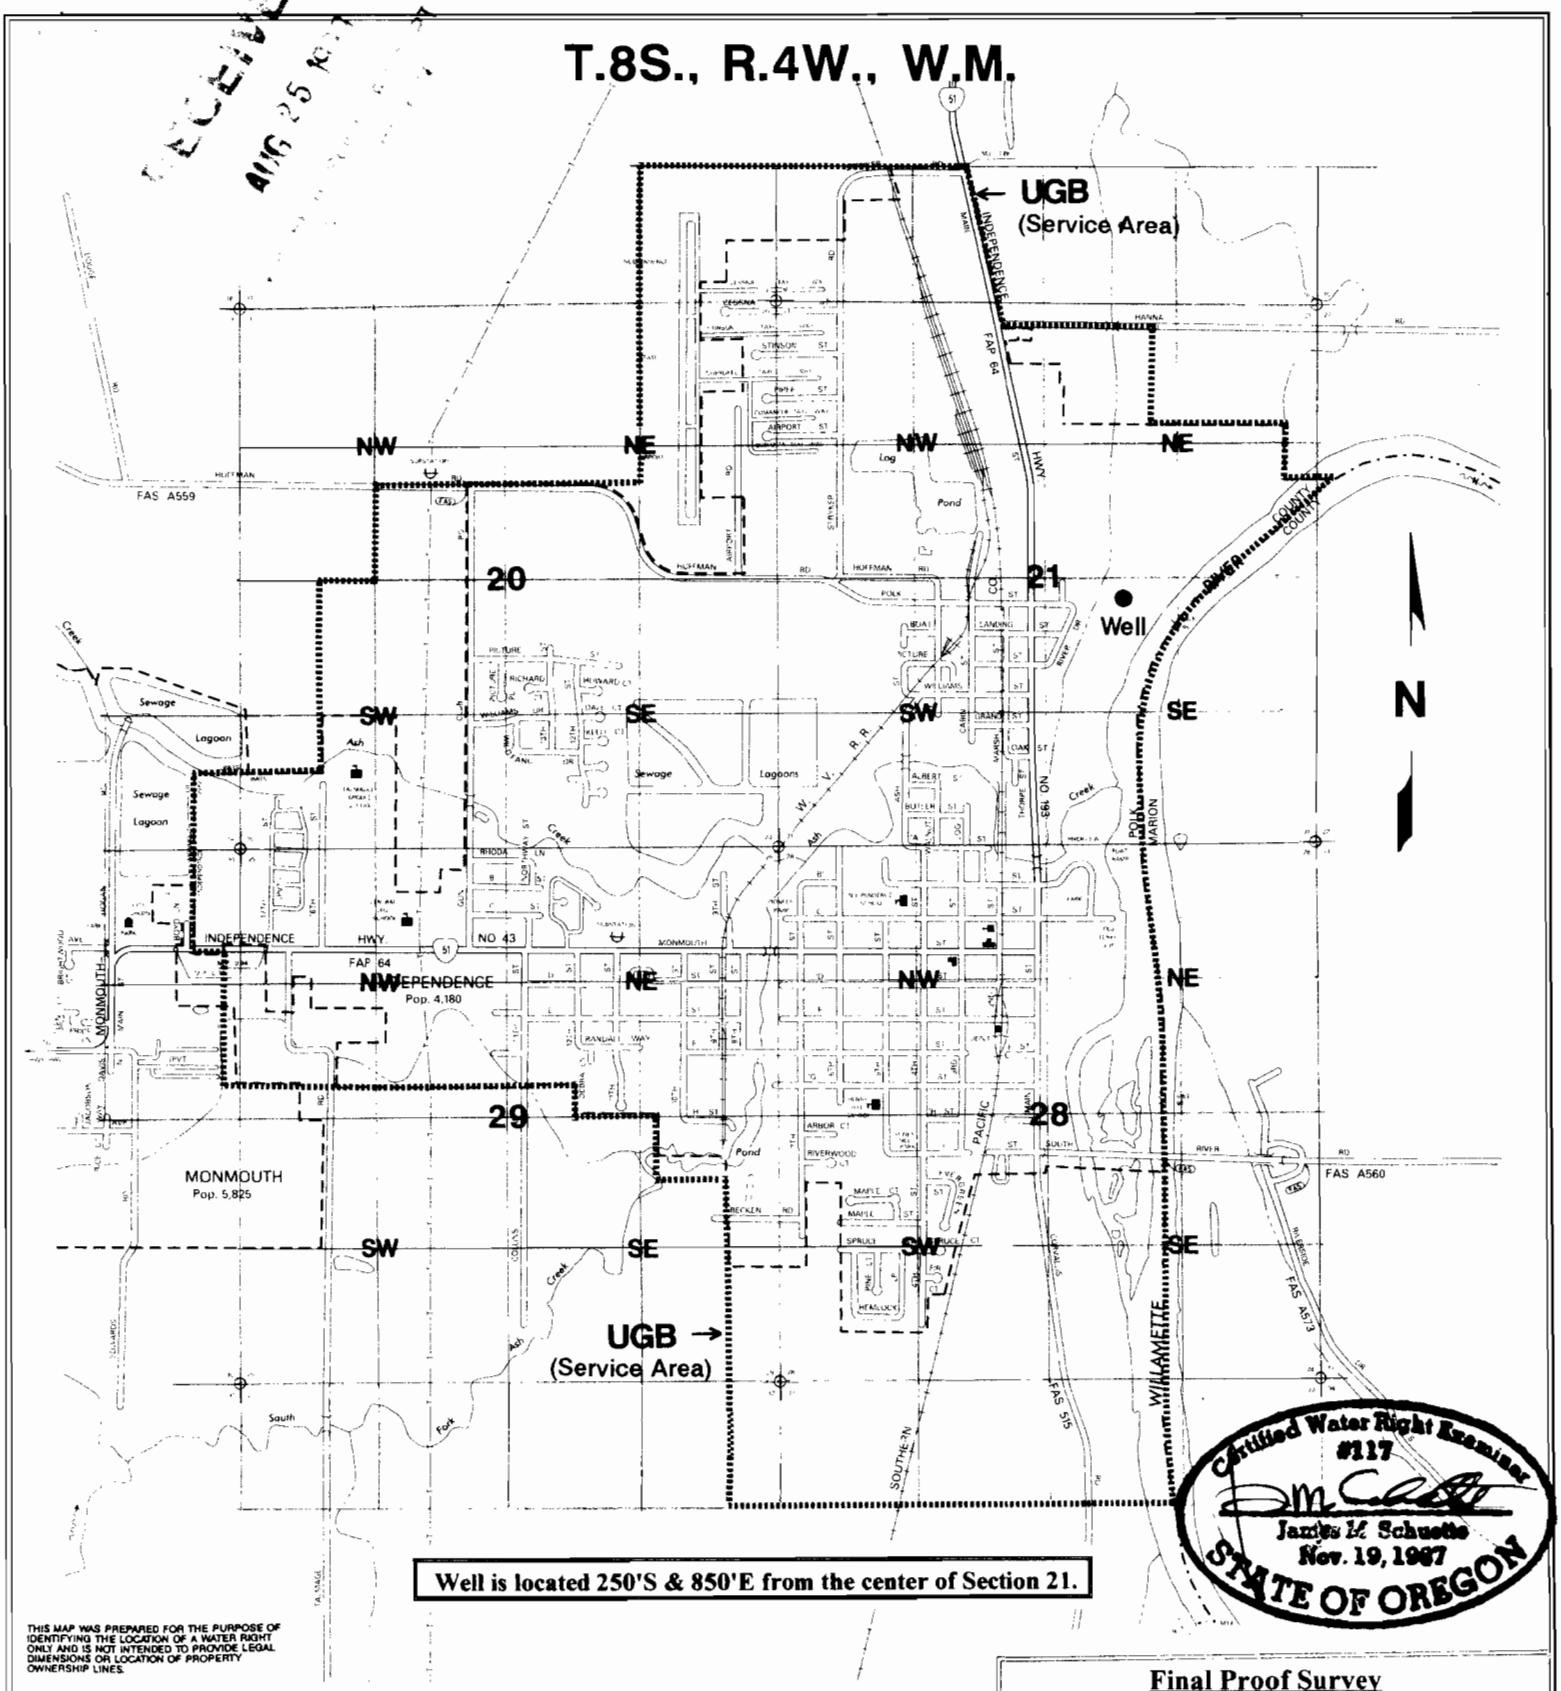

Well is located 250'S & 850'E from the center of Section 21.

THIS MAP WAS PREPARED FOR THE PURPOSE OF IDENTIFYING THE LOCATION OF A WATER RIGHT ONLY AND IS NOT INTENDED TO PROVIDE LEGAL DIMENSIONS OR LOCATION OF PROPERTY OWNERSHIP LINES.

FEET

METERS

Urban Growth Boundary

Final Proof Survey

Application #: G-12736 Permit #: G-12134

In Name Of

City of Independence

Surveyed on August 17, 1999 by JM Schuette