



T.6S., R. 2&3 W., W.M.

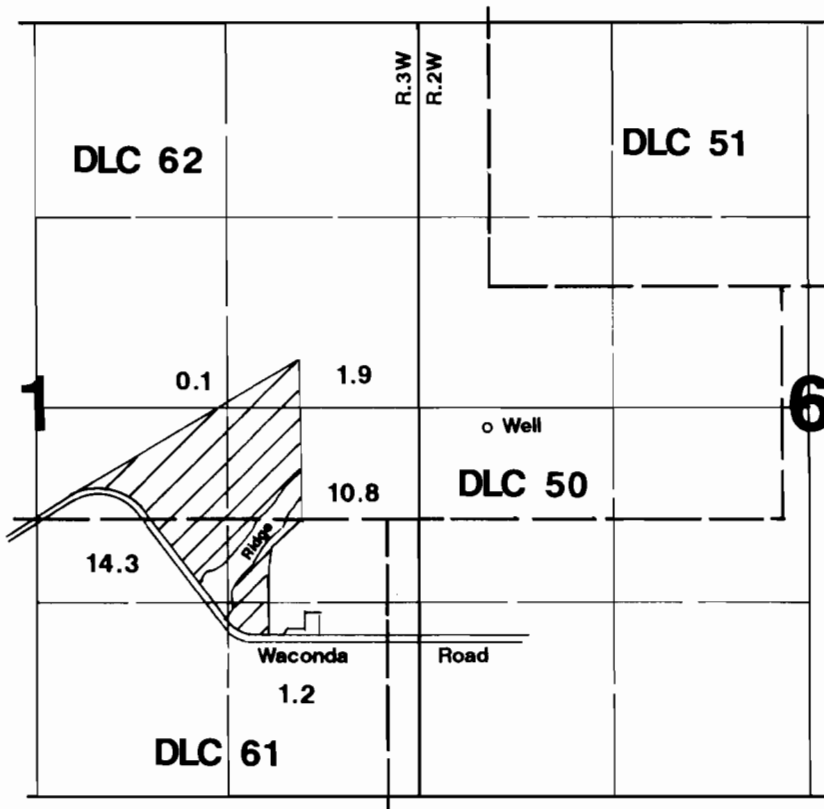

1" = 1320'

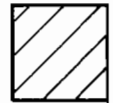

Area Irrigated

Well located 620'N & 620'E from NE corner DLC 61.

RECEIVED

NOV 26 1997

WATER RESOURCES DEPT.
SALEM, OREGON

Final Proof Survey

Application #: G-13157 Permit #: G-12144

In Name Of

Ted V. Bell

Surveyed on November 24, 1997 by JM Schuette

THIS MAP WAS PREPARED FOR THE PURPOSE OF IDENTIFYING THE LOCATION OF A WATER RIGHT ONLY AND IS NOT INTENDED TO PROVIDE LEGAL DIMENSIONS OR LOCATION OF PROPERTY OWNERSHIP LINES.

