


T. 4N., R. 24E., W.M.

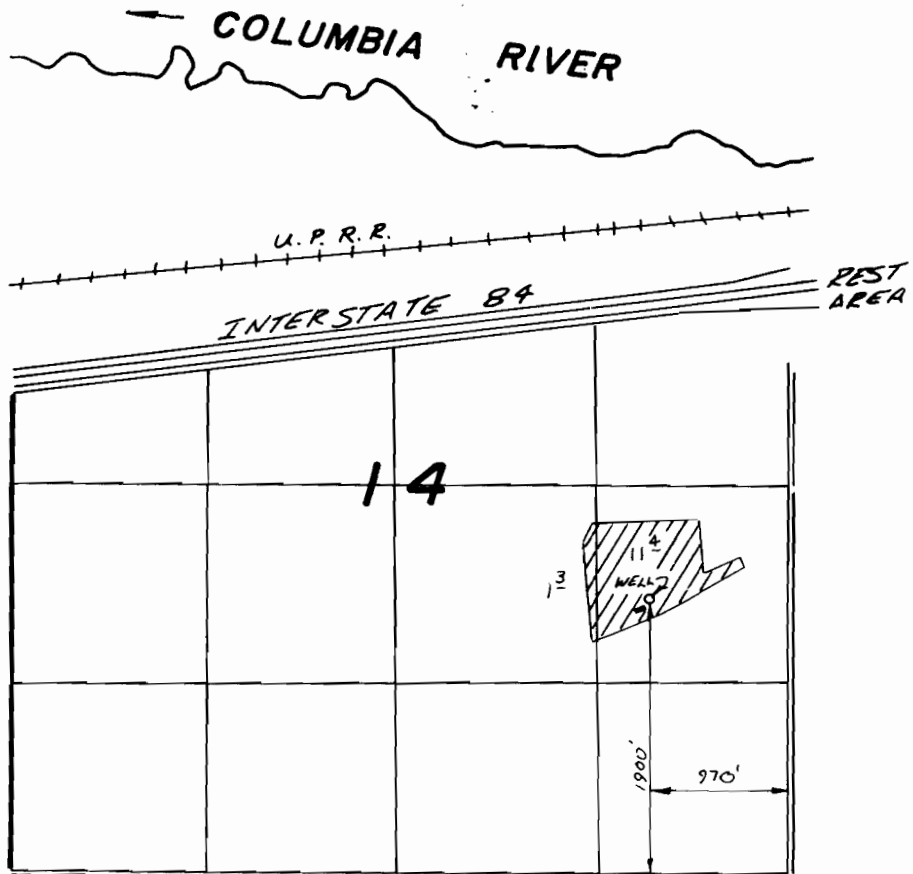

FINAL PROOF SURVEY
UNDER

Application No. **G-8295** Permit No. **G-7828**
IN NAME OF

LARRY DUANE EADES

Surveyed *7-2*..... 19*82*., by *Verona Lee Church*