


# T.4S. R.2 & 3W., W.M

**RECEIVED**  
SEP 16 1989  
WATER RESOURCES DEPT.  
SALEM, OREGON

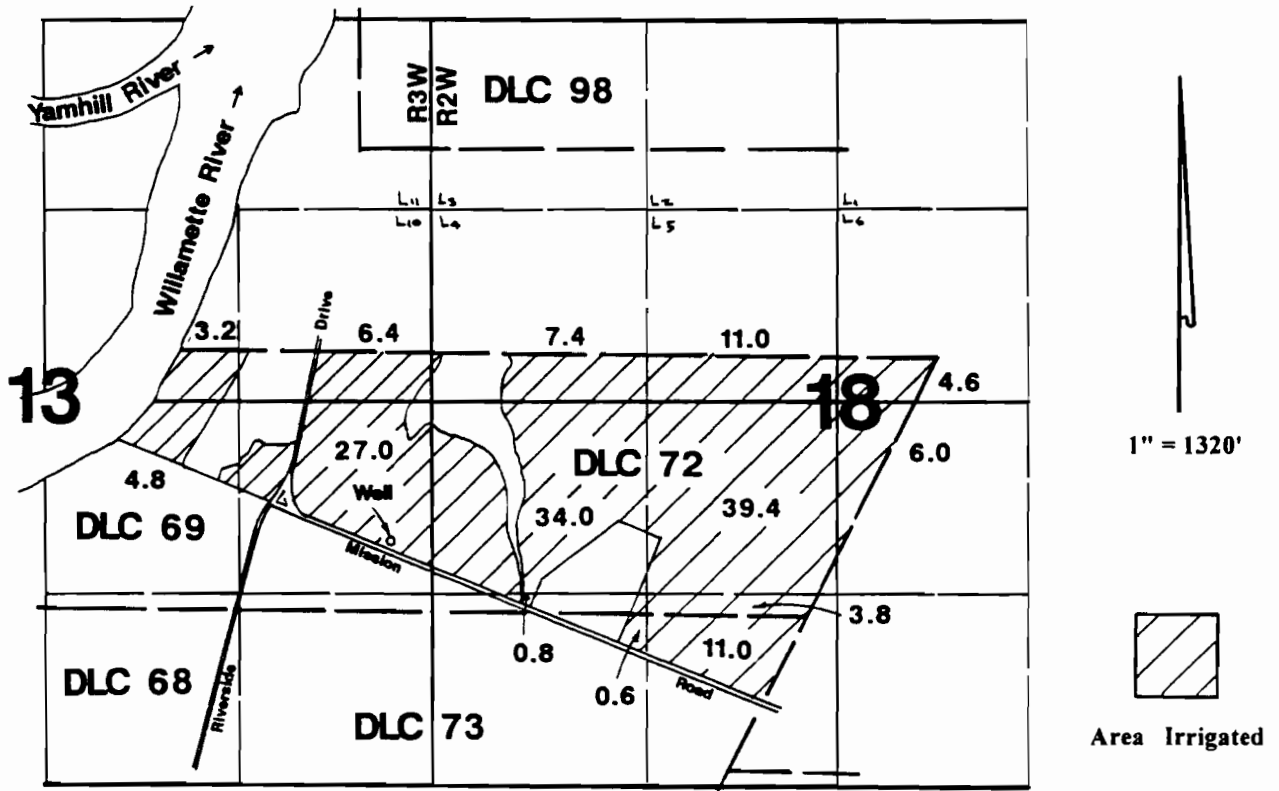

Well is located 950'S & 280'W from the E1/4 corner of Section 13.

## Final Proof Survey

Application #: G-13133 Permit #: G-12186

In Name Of

### Mission Lane Farms

Surveyed on September 3, 1999 by JM Schuette

This Map Was Prepared For The Purpose Of Identifying The Location Of A Water Right Only And Is Not Intended To Provide Legal Dimensions Or Location Of Property Ownership Lines.

