


# T.6S., R.2W., W.M.

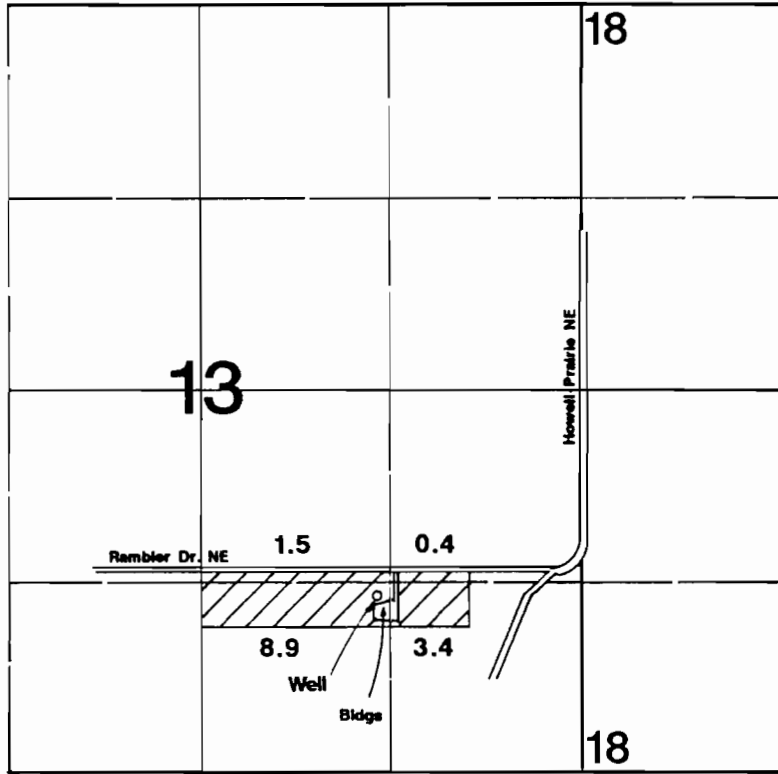

Well is located 1220' N & 1410' W from the SE corner of Section 13.

## Final Proof Survey

In Name Of

### Mark A. & Elsie Sinn

Application #: G-13568

Permit #: G-12198

Surveyed on September 13, 2001 by JM Schuette

This Map Was Prepared For The Purpose Of Identifying The Location Of A Water Right Only And Is Not Intended To Provide Legal Dimensions Or Location Of Property Ownership Lines.

