


Township 5 South, Range 1 West, W.M.

Portions of Sections 35 & 36

RECEIVED

NOV 28 1997

WATER RESOURCES DEPT
SALEM, OREGON

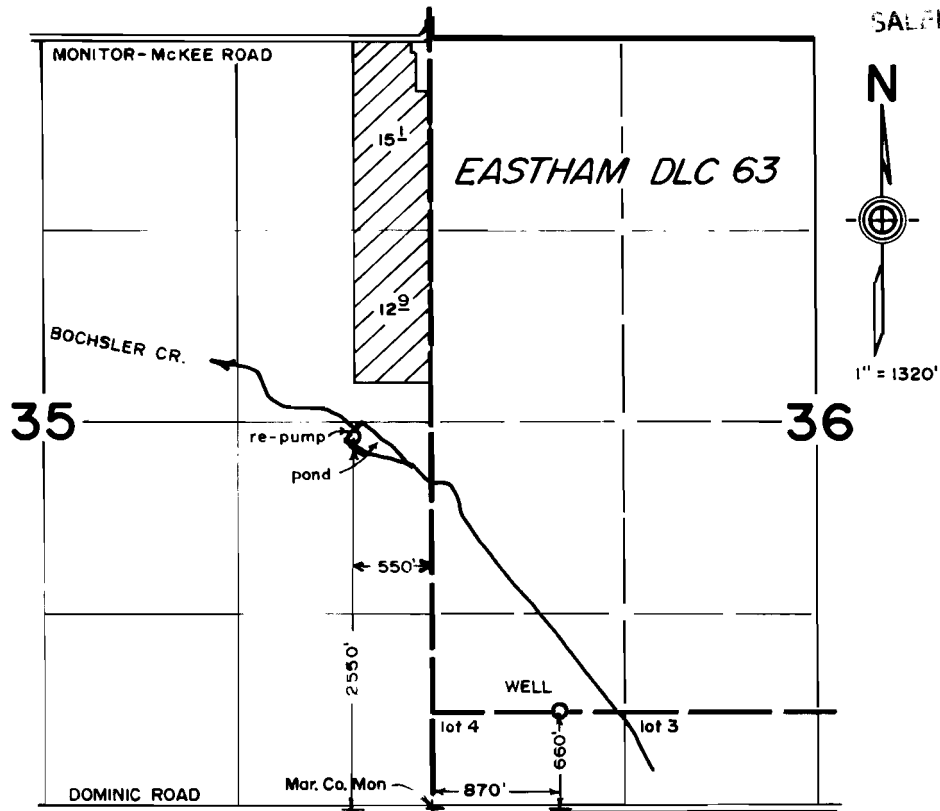

FINAL PROOF SURVEY


under

Appl. No. G-12879, Per. No. G-12201

in name of

DAN HAMMELMAN

Oct. 22, 1997

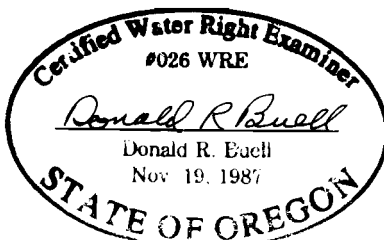

THIS MAP WAS PREPARED FOR THE PURPOSE OF IDENTIFYING THE LOCATION OF A WATER RIGHT ONLY AND IS NOT INTENDED TO PROVIDE LEGAL DIMENSIONS OR LOCATION OF PROPERTY OWNERSHIP LINES.