

RECEIVED

MAR 16 2000

WATER RESOURCES DEPT  
SALEM, OREGON

**FINAL PROOF MAP**  
**Section 4, T.40S. R.19E., W.M.**  
Lake County, Oregon


APPLICATION #G-12446 PERMIT #G-12245



SCALE

1" = 1320'


TAX LOTS 901 & 902

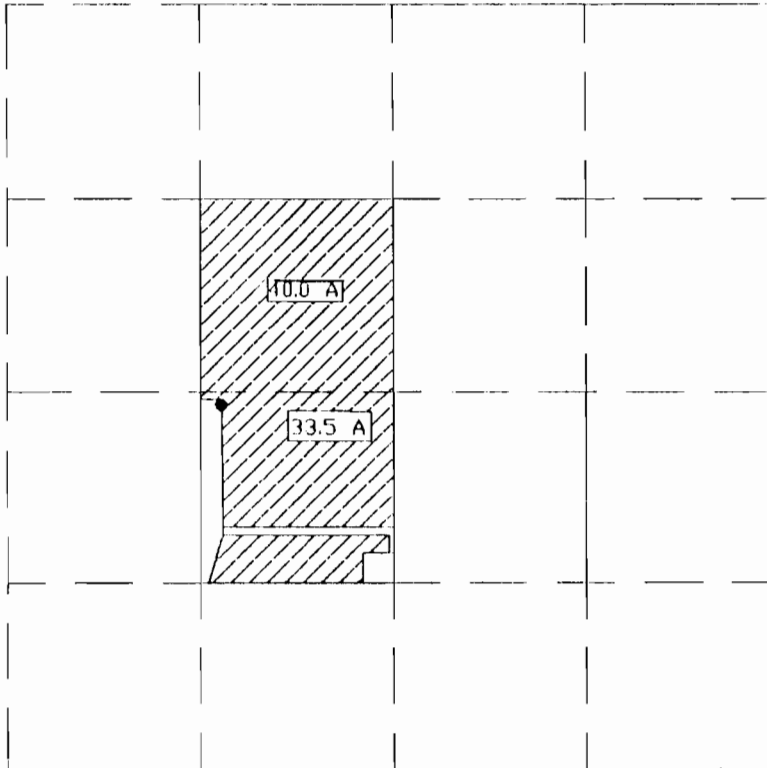

Well is located 150' East and 91' South  
of the CW 1/16 corner

Prepared for: Samuel Farr  
Prepared by: Sundet & Associates  
P.O. Box 1228  
Lakerview, OR 97630  
541-947-3293

March 2000 Drawing #11500

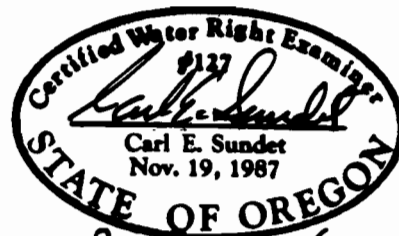

*Reviews 6/24/00*

This map is for the purpose of identifying the location of  
the water right only and is not intended to provide legal  
dimensions or property ownership lines.