

RECEIVED

MAY 10 1999

WATER RESOURCES DEPT.
SALEM, OREGON


PERMIT AMENDMENT MAP

UNDER

APPLICATION NO. G-12529
PERMIT NO. G-12264
IN NAME OF

KILCHIS WATER DISTRICT
TILLAMOOK COUNTY, OREGON
SURVEYED APRIL 26, 1999

T-8265

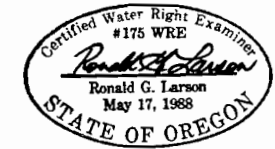


NO CHANGE TO
AUTHORIZED
PLACE OF USE
WHICH IS
BOUNDARY OF
WATER DISTRICT
SHOWN TO THE
NEAREST WHOLE
1/4 - 1/4 SECTION

THE PURPOSE OF THIS MAP IS TO IDENTIFY
THE LOCATION OF THE WATER RIGHT. IT IS
NOT INTENDED TO PROVIDE INFORMATION
RELATIVE TO THE LOCATION OF PROPERTY
OWNERSHIP BOUNDARY LINES.

"04600202.DWG"

HLB & ASSOC., INC.
SURVEYING • ENGINEERING • PLANNING
TILLAMOOK COUNTY
160 LANEDA AVE.
MANZANITA, OR 97130
(503) 368-5394
FAX: (503) 368-5847

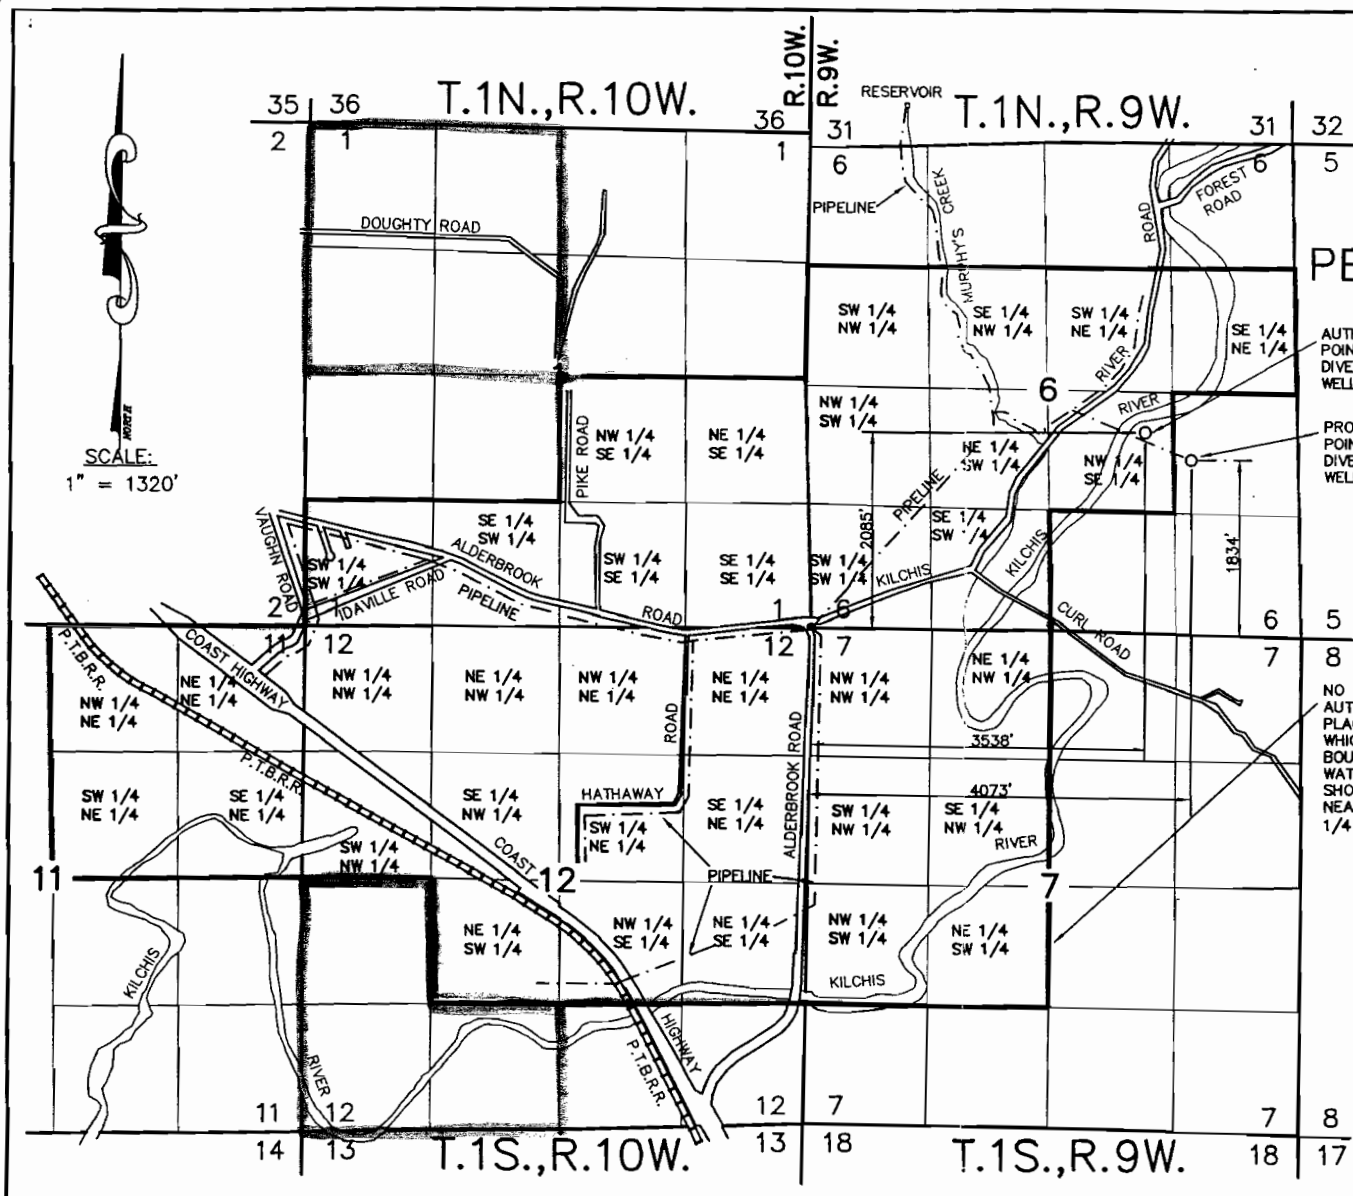

AUTHORIZED
POINT OF
DIVERSION
WELL NO.2

PROPOSED
POINT OF
DIVERSION
WELL NO.2