



T.5S., R.4W. W.M.

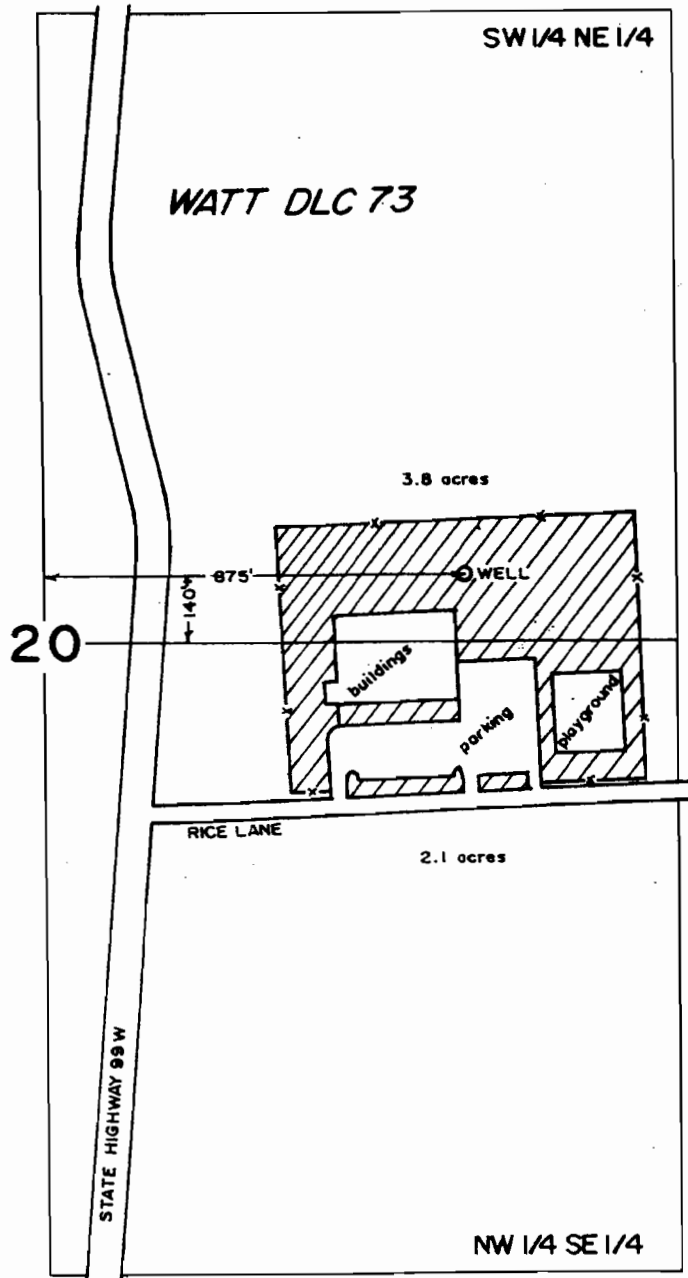

EXPIRATION DATE: 12/31/02

Permit No. G-13464
Application No. G-12304

Scale: 1" = 400'

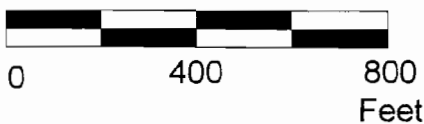

This map was prepared for the purpose of identifying the location of a water right only and is not intended to provide legal dimensions or location of property ownership lines.



Claim of Beneficial Use

Amity Public Schools
T.5S. R.4W. Sec. 20, Tax Map 5 4 20DB, TL 201

Pacific Hydro-Geology Inc.