WATER R HT MAP

application G 13505

permit G12307

FOR: LEONARD BIZON
RT. 1, BOX 429
HUBBARD, ORE.

TOWNSHIP 4 SOUTH, RANGE 1 WEST, W.M. — SECTIONS ~~31 & 32~~

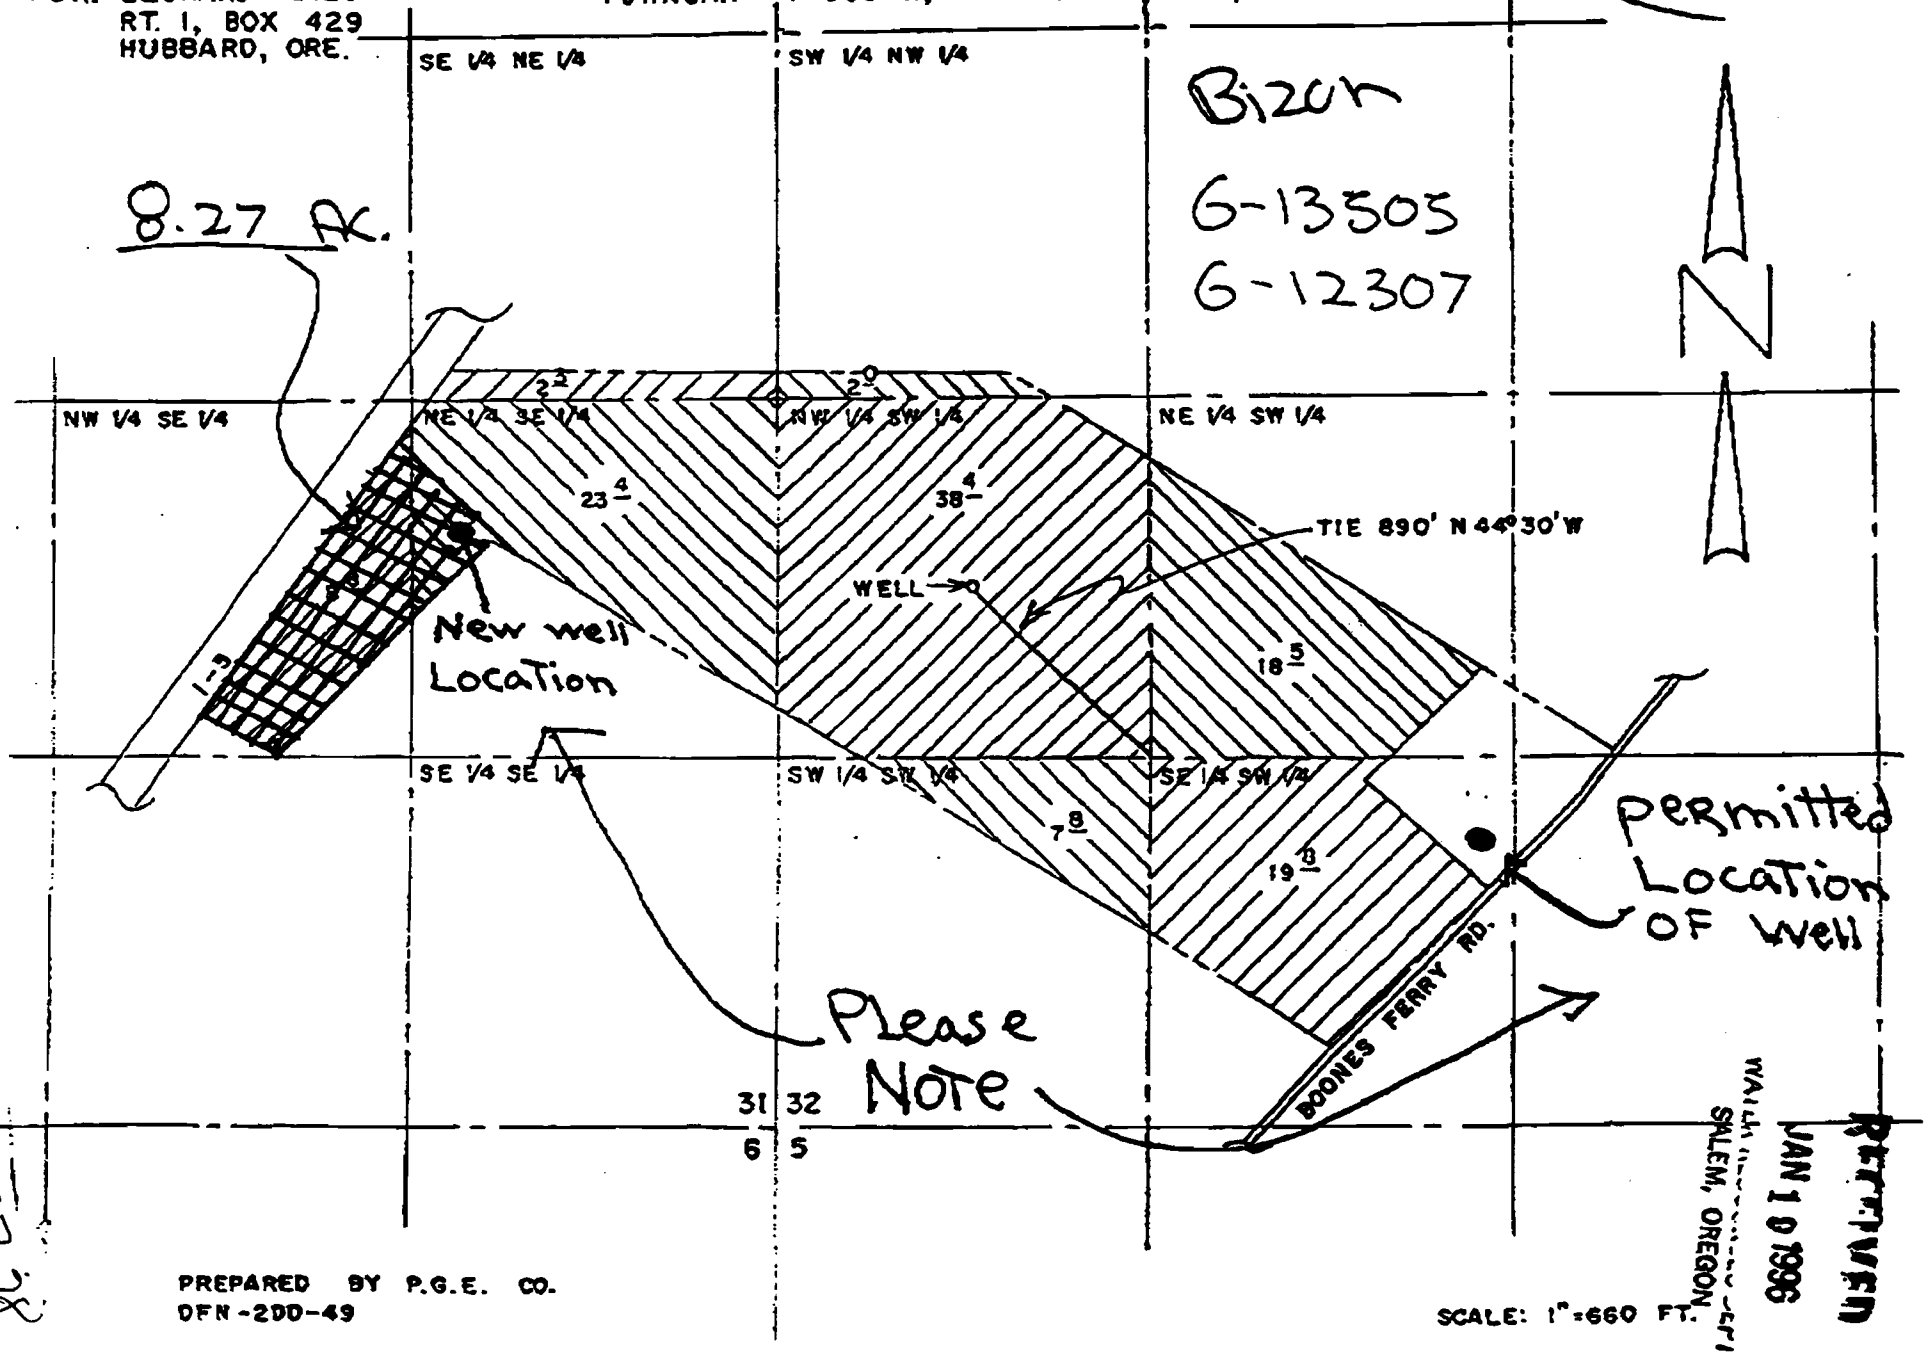

PREPARED BY P.G.E. CO.
DFN-200-49

SCALE: 1"=660 FT.

RECEIVED
JAN 10 1996
WATER RESOURCES DEPT.
SALEM, OREGON

T 7 S R 2 W