


RECEIVED

SEP 21 1999

WATER RESOURCES DEPT  
SALEM, OREGON

# T.6S. R.2W., W.M

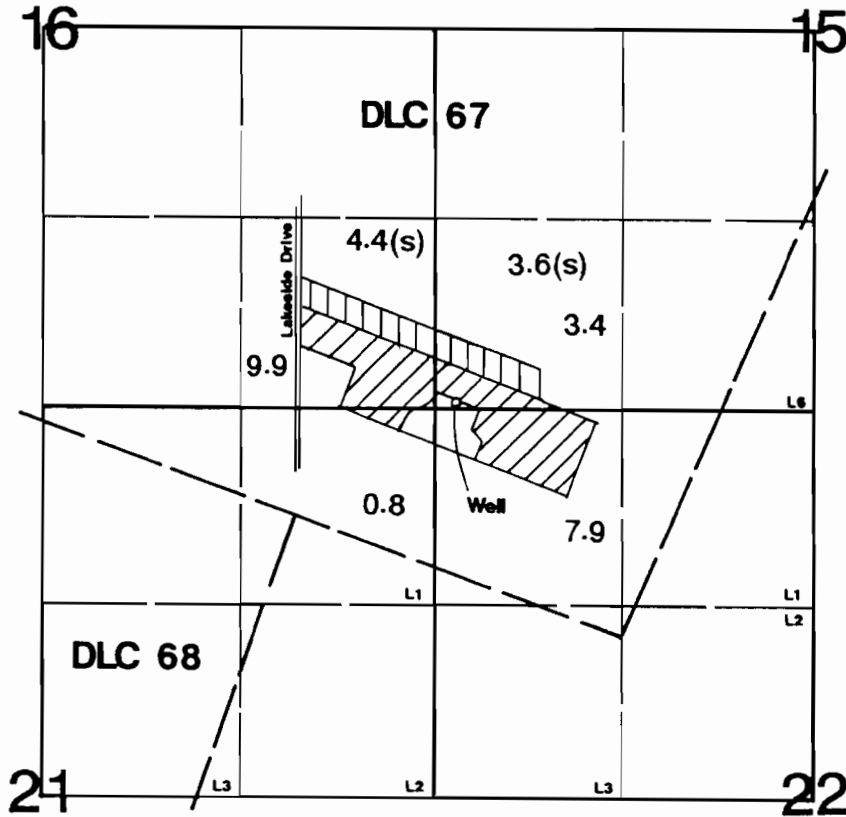

Well is located 780'N & 1090'E from the NE corner of DLC 68.

## Final Proof Survey

Application #: G-13478 Permit #: G-12310

In Name Of

### Melvin R. Franke

Surveyed on September 14, 1999 by JM Schuette

This Map Was Prepared For The Purpose Of Identifying The Location Of A Water Right Only And Is Not Intended To Provide Legal Dimensions Or Location Of Property Ownership Lines.

