


# Township 5 North, Range 29 East, W.M.

## SE 1/4 of SE 1/4 of SW 1/4 of Section 29

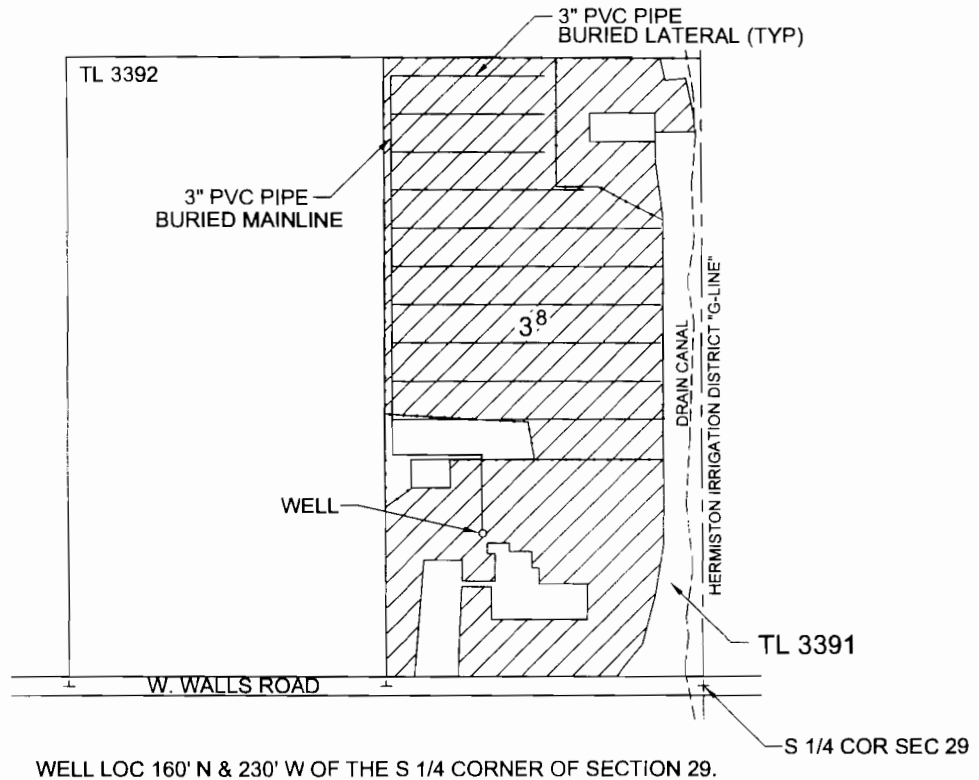

SCALE 1" = 200'

### FINAL PROOF SURVEY


under

Appl. No. G-13451, Per. No. G-12349

in name of

PAT DEISCH

November 7, 2003

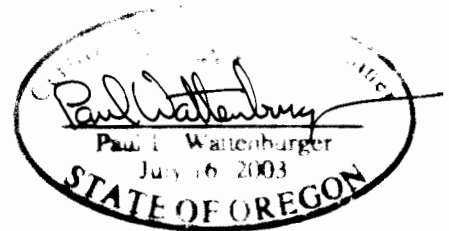

EXPIRES 6/30/04

THIS MAP WAS PREPARED FOR THE PURPOSE OF IDENTIFYING THE LOCATION OF A WATER RIGHT ONLY AND IS NOT INTENDED TO PROVIDE LEGAL DIMENSIONS OR LOCATION OF PROPERTY OWNERSHIP LINES.