


T.6S. R.1W. Sec. 36 and T.6S. R.1E. Sec. 30 & 31

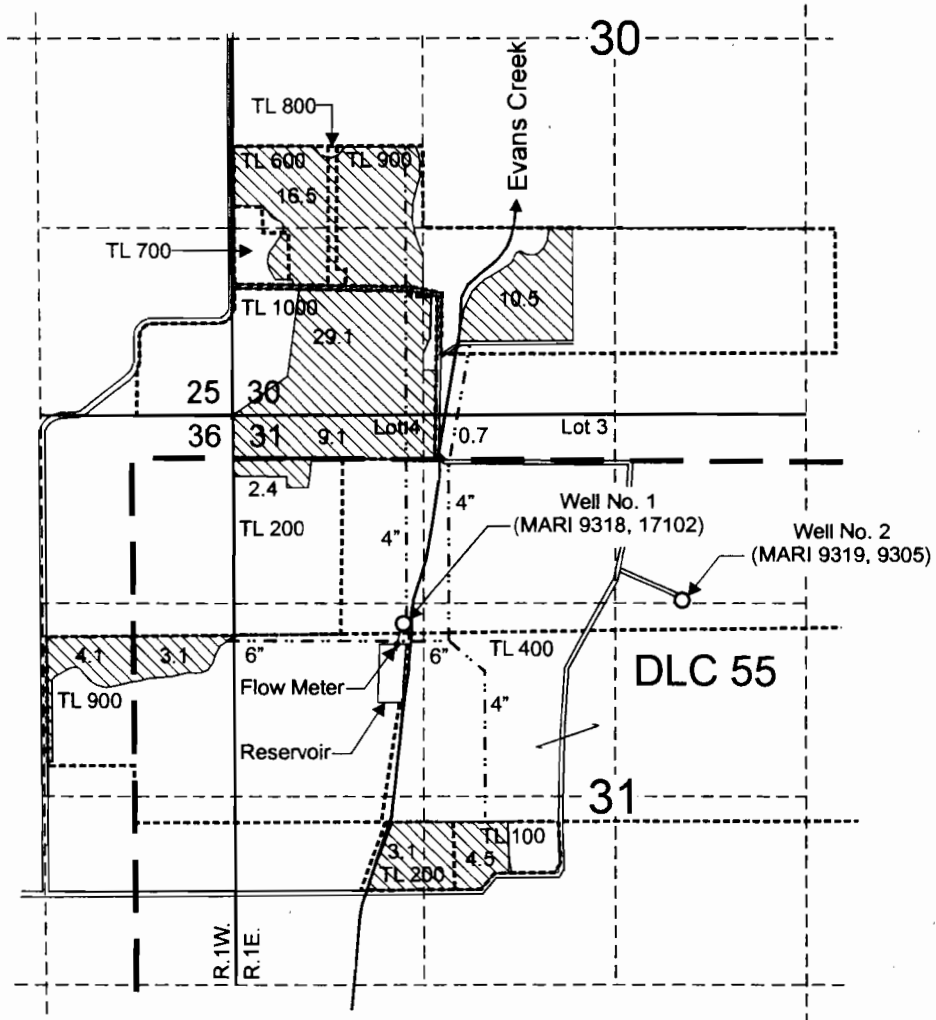


Well 1 (MARI 9318, 17102) is located 1,450 feet south and 1,170 feet east from the NW corner of Section 31.
Well 2 (MARI 9319, 9305) is located 1,290 feet south and 3,100 feet east from the NW corner of Section 31.

 Area (82.5 Acres) of supplemental Irrigation under Application G-12592, Permit G-12353.


- - - - - Buried Mainline

----- Tax Lot Boundary

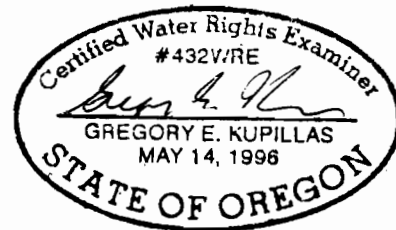

EXPIRATION DATE: 6/30/05

Scale: 1" = 1,320'

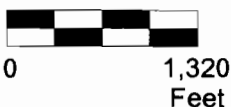

This map was prepared for the purpose of identifying the location of a water right only and is not intended to provide legal dimensions or location of property ownership lines.



Claim of Beneficial Use Map

Kevin Loe
T.6S. R.1W. Sec. 36 and
T.6S. R.1E. Sec. 30 and 31

Pacific Hydro-Geology Inc.

10/2004

LoeGW.cdr