


Township 4 North, Range 28 East, W.M.

NE 1/4 of NW 1/4 of Section 1

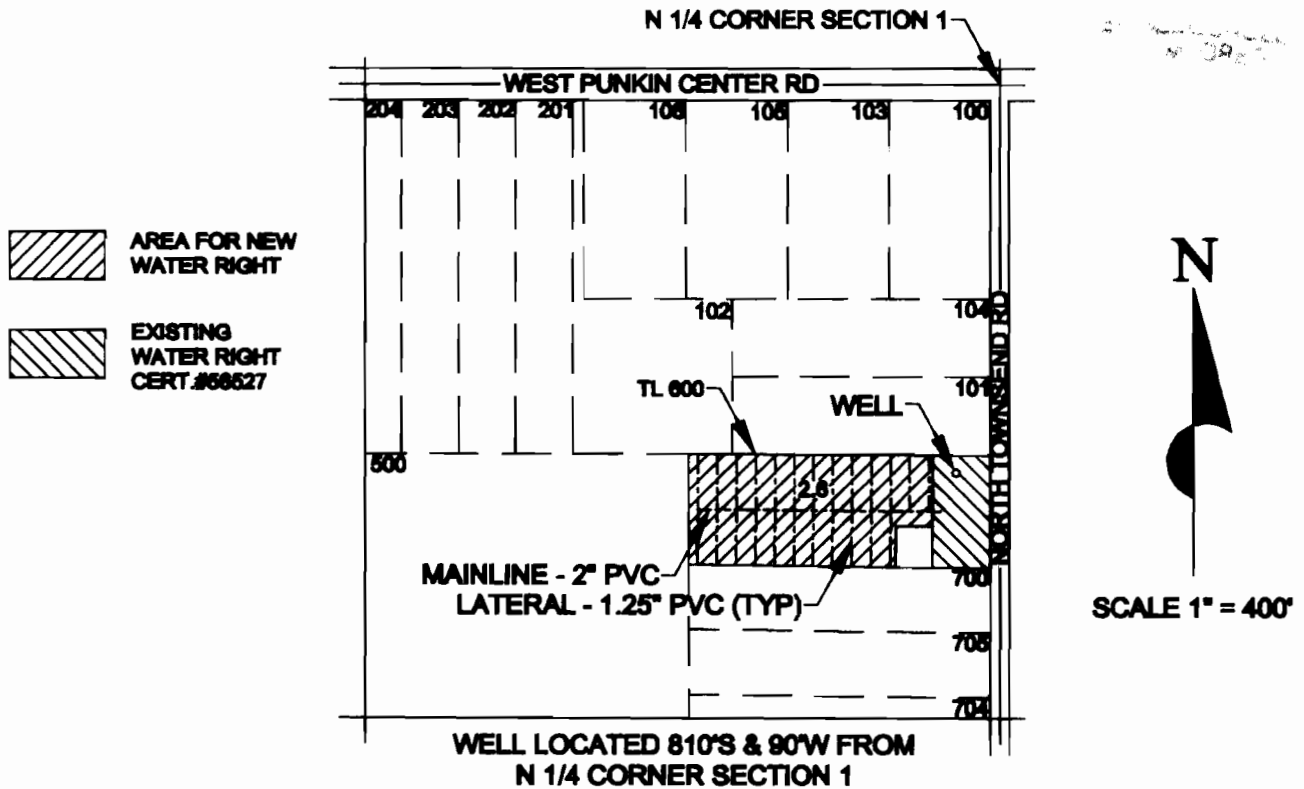

FINAL PROOF SURVEY


under

Appl. No. G-12970, Per. No. G-12357

in name of

THOMAS JEPPE

October 2, 2003

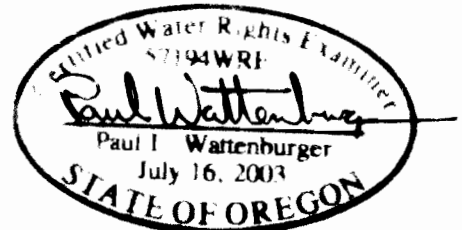

EXPIRES 6/30/04

THIS MAP WAS PREPARED FOR THE PURPOSE OF IDENTIFYING THE LOCATION OF A WATER RIGHT ONLY AND IS NOT INTENDED TO PROVIDE LEGAL DIMENSIONS OR LOCATION OF PROPERTY OWNERSHIP LINES.