

# FINAL PROOF SURVEY AND CLAIM OF BENEFICIAL USE

LOCATED WITHIN  
NW 1/4, SW 1/4, SECTION 25, T.6N., R.35E., W.M  
UMATILLA COUNTY, OREGON

APPLICATION G-13,277

PERMIT G-12,361

APPLICANT: HAROLD E. AKES

1/4 S26|S25

SW 1/4,  
NW 1/4

SE 1/4,  
NW 1/4

NEW POINT OF  
APPROPRIATION IS 805  
FEET SOUTH AND  
1,250 FEET EAST OF  
1/4 S26|S25

WELL

STATE  
HIGHWAY  
NO. 11

NW 1/4,  
SW 1/4

NE 1/4,  
SW 1/4

LEGEND

SW 1/4,  
SW 1/4

SE 1/4,  
SW 1/4

--- 1/16TH SECTION LINE



PLACE OF USE  
4.13 ACRES WITHIN NW 1/4, SW  
1/4, S26, T.6N., R.35E., W.M.

400' 0' 400'  
1" = 400'


**RECEIVED**

JUL 17 2000

WATER RESOURCES DEPT.  
SALEM, OREGON



THIS MAP IS PREPARED FOR THE EXPRESS PURPOSE TO SHOW WATER APPROPRIATION AND USE. IT IS NOT INTENDED TO SHOW OR LOCATE PROPERTY OWNERSHIP LINES.

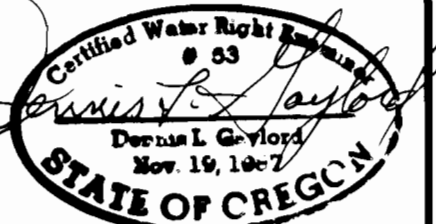

RENEWS 6/30/2001

DENNIS L. GAYLORD,  
CWRE  
71614 S.W. LAKE DRIVE  
PENDLETON, OR 97801  
(541)-276-6260 ©

JULY, 2000

Drawn by: Mill Creek Drafting