



T.5S., R.1.W, W.M

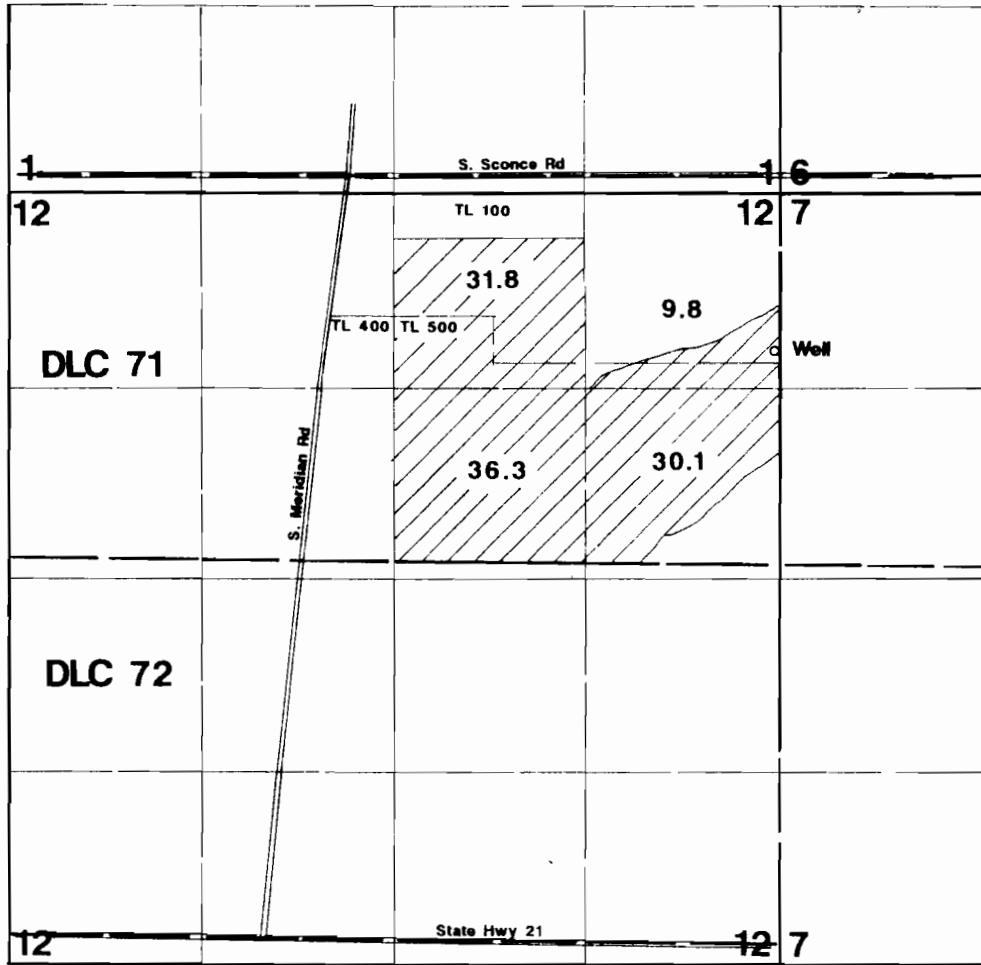

1" = 1320'

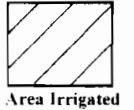

Well is located 1055'S & 35'W from the NE corner of Section 12.

Final Proof Survey

In Name Of

Bronec Bros.

Application #: G-13453

Permit #: G-12383

Surveyed on November 25, 2002 by JM Schuette

This Map Was Prepared For The Purpose Of Identifying The Location Of A Water Right Only And Is Not Intended To Provide Legal Dimensions Or Location Of Property Ownership Lines.

