


T. 7 S. R. 1 W. W.M.

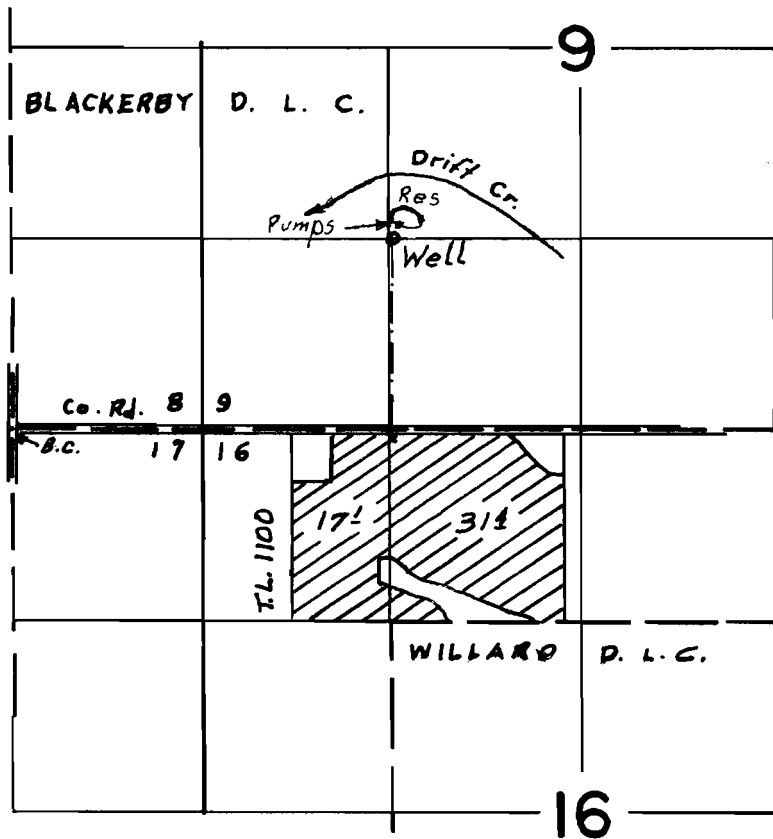

Scale
4" = 1 Mi.

Well loc. 1320' N & 2700' E From S.W. Cor-Blackerby DLC

FINAL PROOF SURVEY UNDER


~~RECORDED~~

SEP 05 2000

~~STATE OF OREGON~~

Application No. G-13427 Permit No. G-12410
IN NAME OF

HARRY KLOPFENSTEIN

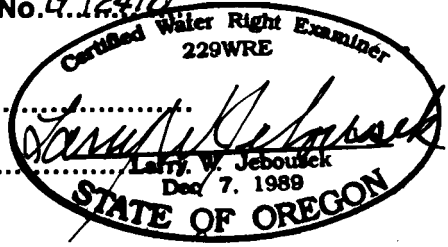

Surveyed Aug. 5, 2000, by

THIS MAP WAS PREPARED FOR THE PURPOSE OF IDENTIFYING THE LOCATION OF A WATER RIGHT ONLY AND IS NOT INTENDED TO PROVIDE LEGAL DIMENSIONS OR LOCATION OF PROPERTY OWNERSHIP LINES.