# TOWNSHIP 4 SOUTH, RANGE 13 EAST, W.M.

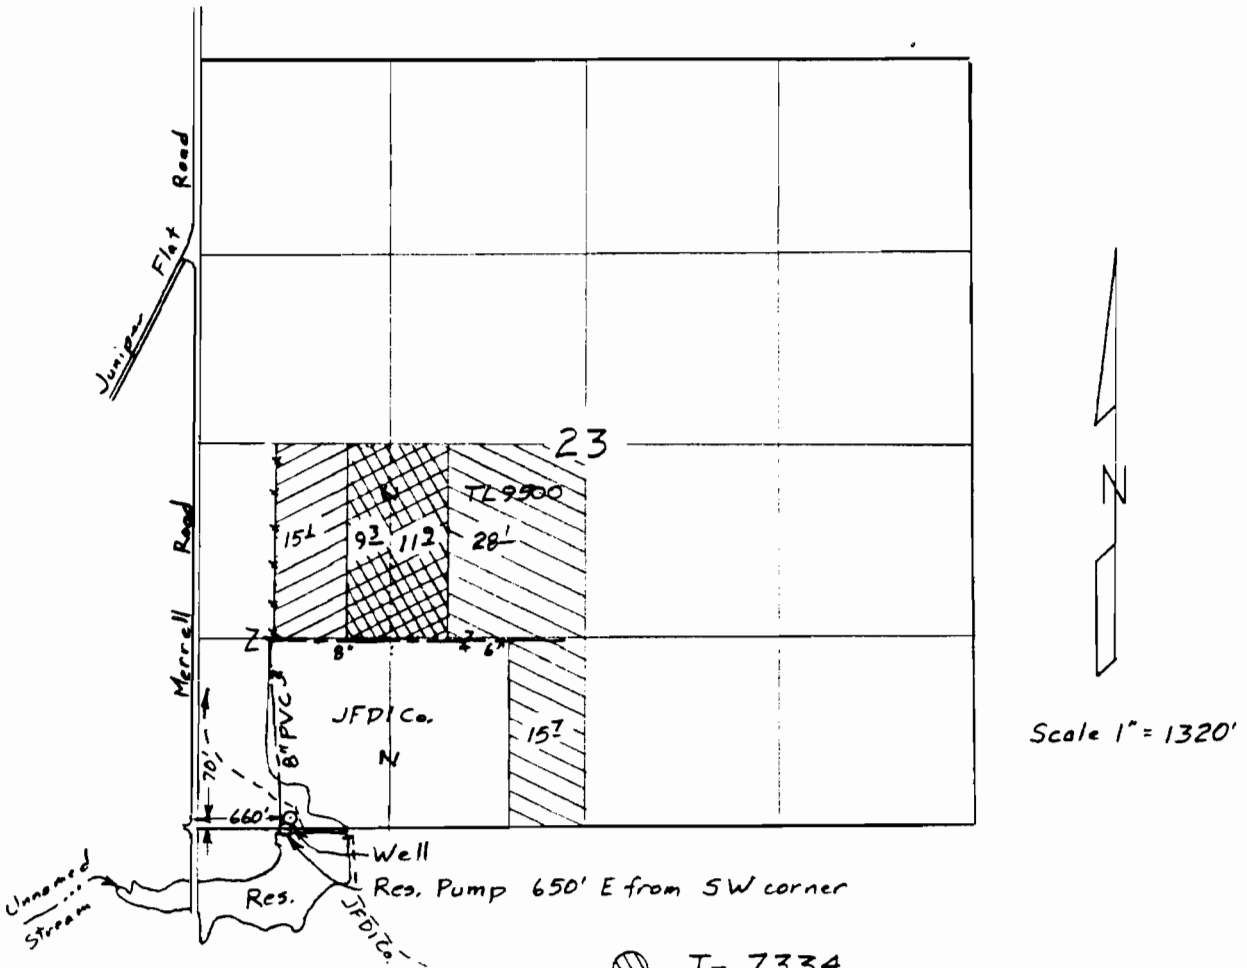


Surveyed Aug 16, 1999

- T- 7334
- G- 12414 Primary
- G- 12414 Supplemental

## Claim of Beneficial Use Map
## for
## RANDY & PENNI DELCO

App G-13747 Per G-12414
&
T- 7334

Certified Water Right Examiner #1
Bruce A. Estes
Nov. 19, 1987
STATE OF OREGON

This map is for the purpose of locating a water right only and has no intent to provide legal dimensions or the location of property lines.


**ESTES SURVEYS**
6293 Sunnyview Rd. NE
Salem, OR 97305
(503) 585-7593
60382 Arnold Rd.
Bend, OR 97702
(503) 382-7391