


T. 8S., R. 40E., W.M.

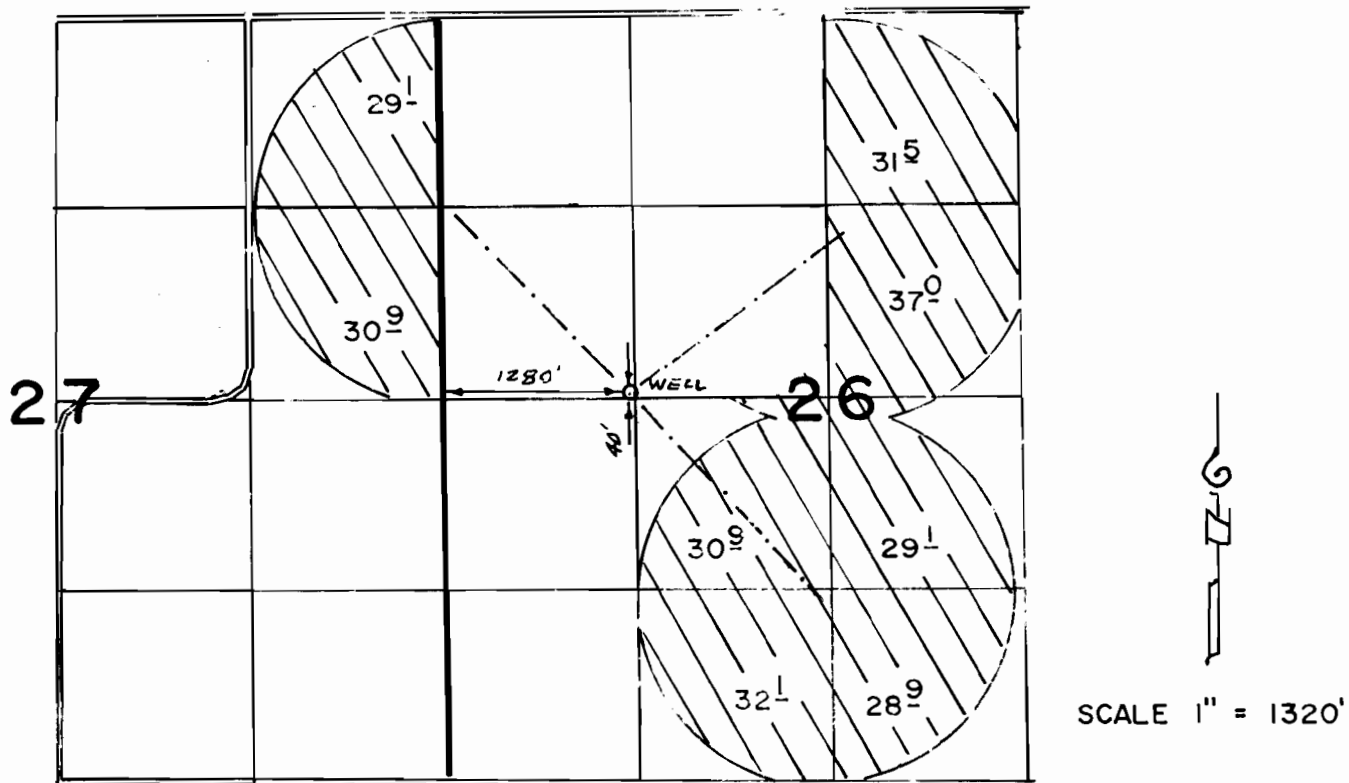

The purpose of this map is for identifying the location of the water right only and is not intended to provide legal dimensions of property ownership lines.

FINAL PROOF SURVEY

UNDER

APPL. G-12448

PER. G-12423

IN NAME OF

RALPH WARD

Surveyed June 1, 1998

James D. Harley
JAMES D. HARLEY
SURVEYOR