

T 7785

RECEIVED


JUN 05 1997

WATER RESOURCES DEPT
SALEM, OREGON

T.7S. & 8S., R.4W., W.M.

Scale: 1" = 1320'

NOTE: MAP IS FOR
PURPOSE OF IDENTIFYING
LOCATION OF WATER RIGHT AND
HAS NO INTENT TO DIMENSION
OR LOCATE PROPERTY OWNERSHIP
LINES.

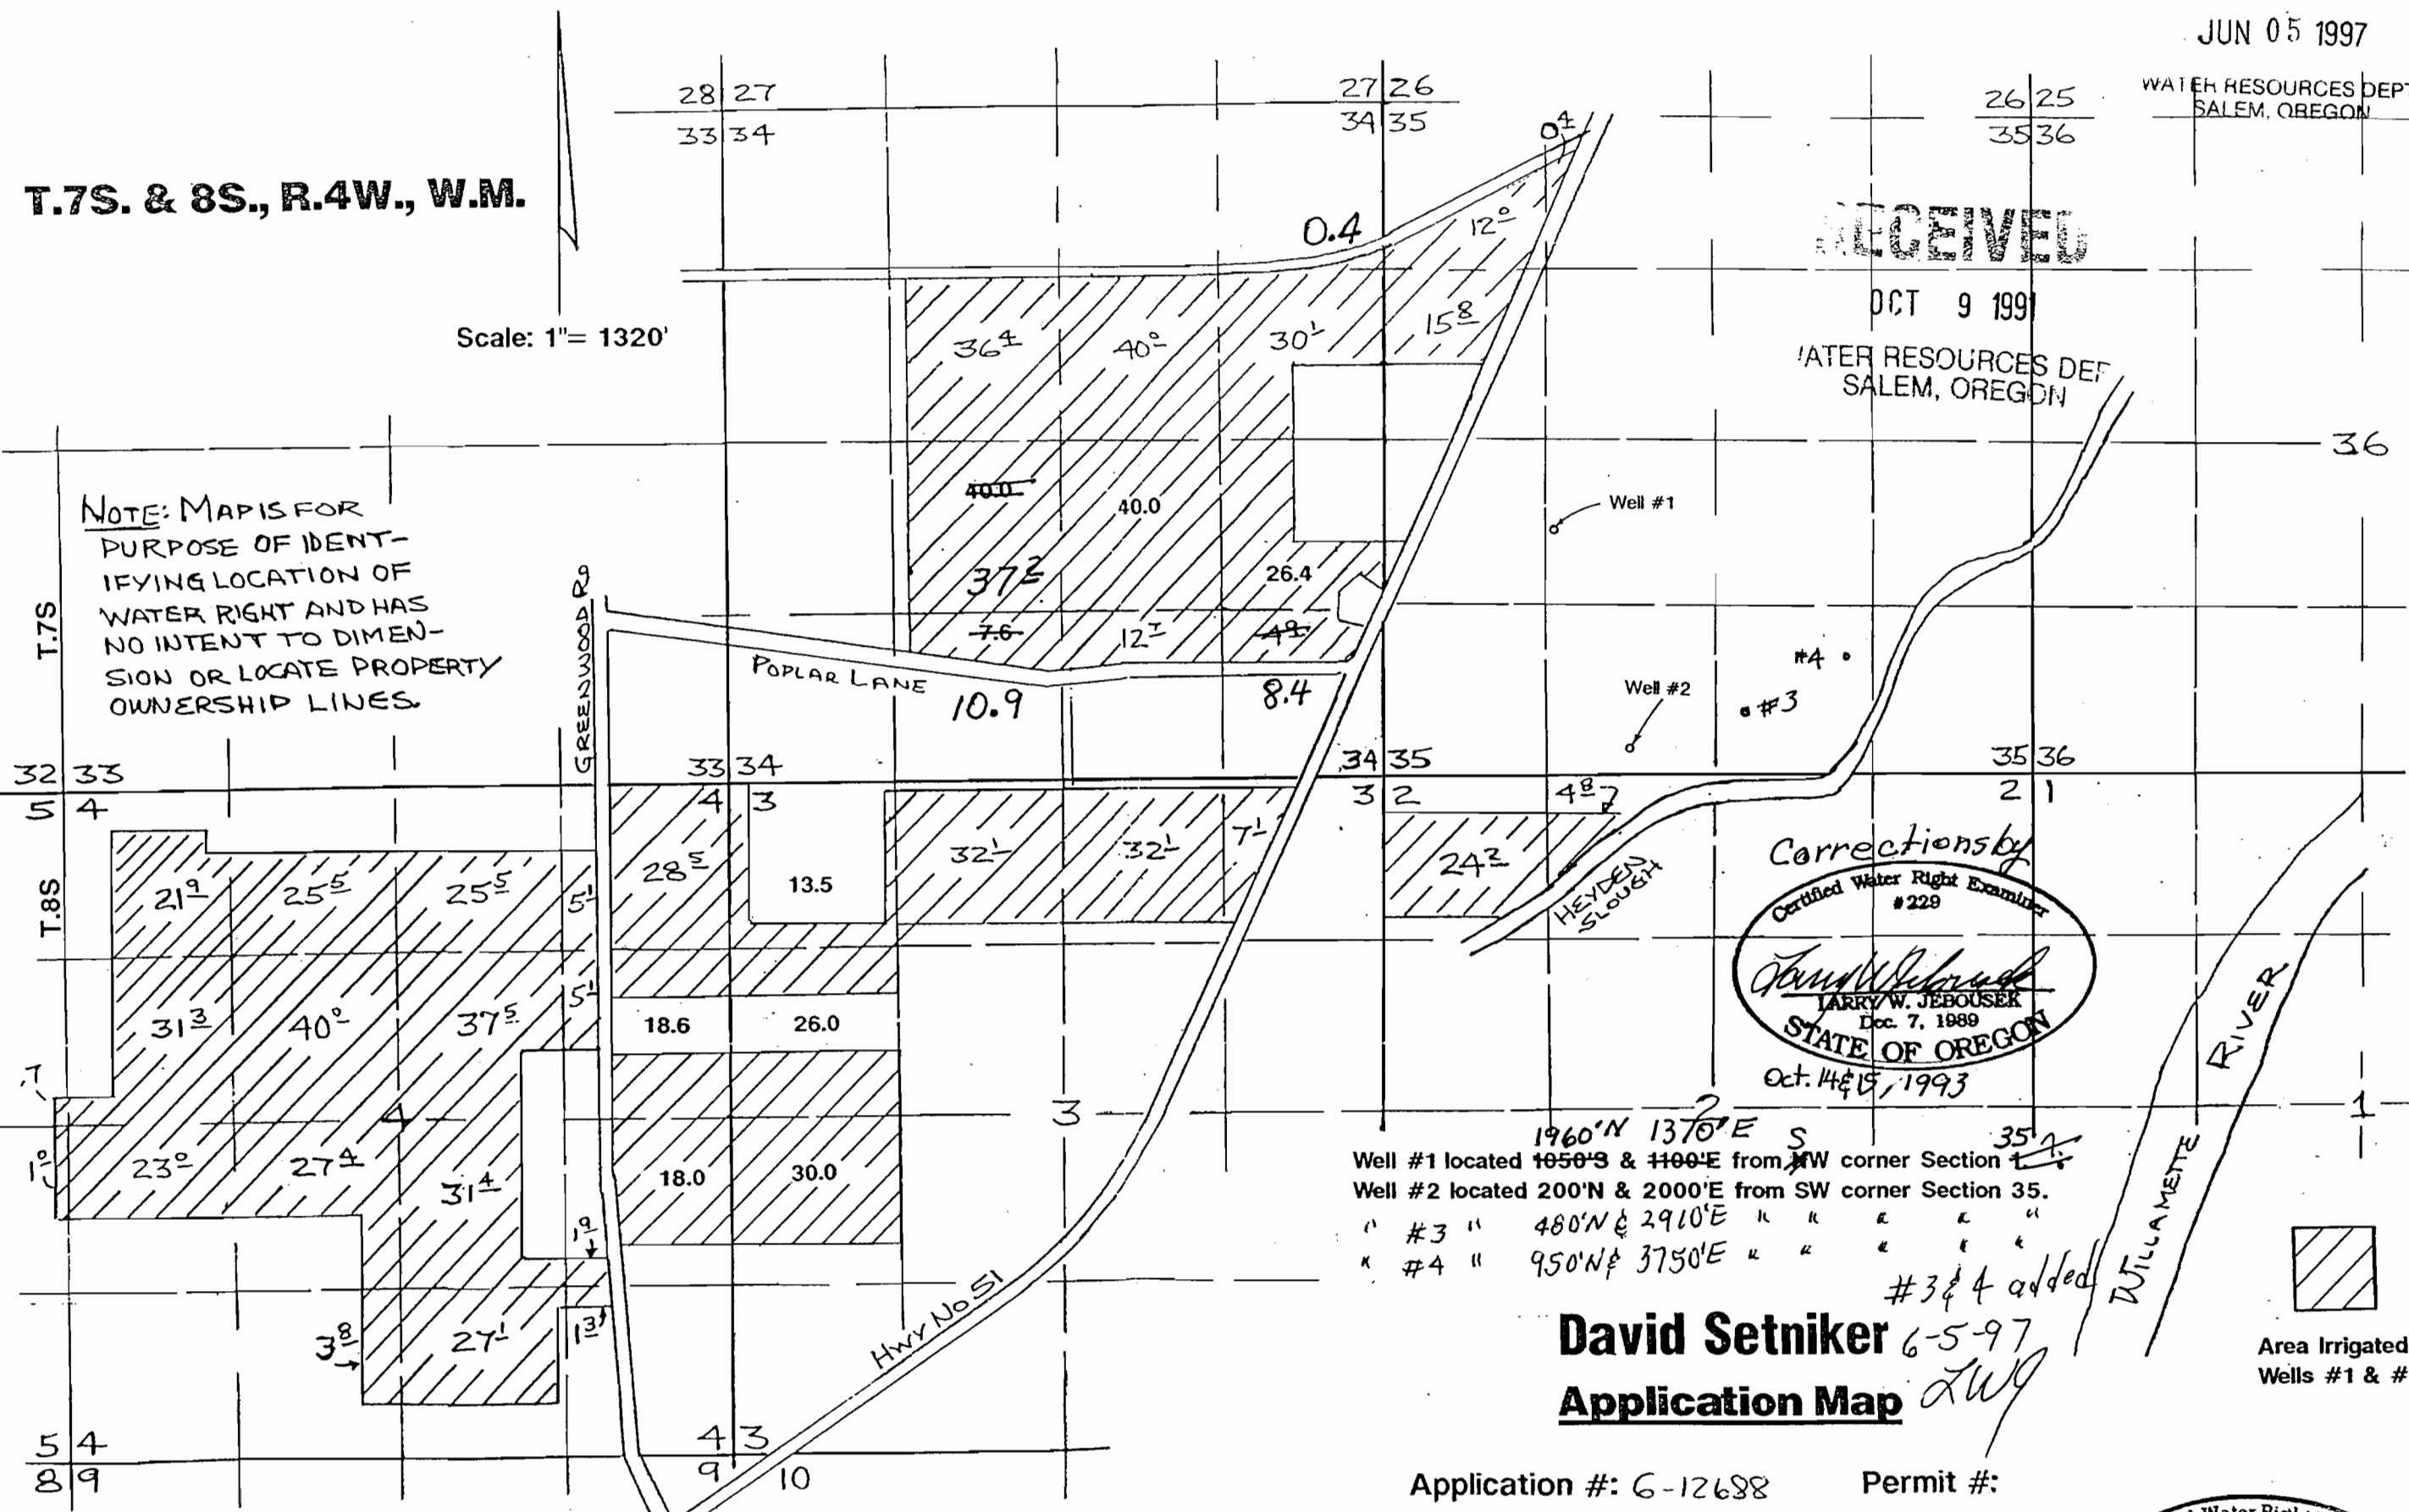

RECEIVED


WATER RESOURCES DEPT
SALEM, OREGON

Corrections by
 Certified Water Right Examiner
 #229
Larry W. Jebousek
 LARRY W. JEBOUSEK
 Dec. 7, 1989
 STATE OF OREGON
 Oct. 14 & 15, 1993

 Well #2 located 200'N & 2000'E from SW corner Section 35.
 " #3 " 480'N & 2910'E " " " " "
 " #4 " 950'N & 3750'E " " " " "

#3 & 4 added

David Setniker 6-5-97
Application Map *DSW*

Application #: G-12688

Permit #:

Certified Water Right Examiner
 #058
James Grimm
 James Grimm
 Nov 19 1987

Area Irrigated
Wells #1 & #2