

SURVEYED FEB. 17 - MAY 5, 1999

FOR: JOHN & MARGIE DARK AND THOMAS & KATHY SILBERNAGEL


BY: C.W.R.E. No. 240

T40S R12E W.M. FINAL PROOF SURVEY

APPLICATION No. G-12935

PERMIT NO. G-12432

SECTION
CORNER

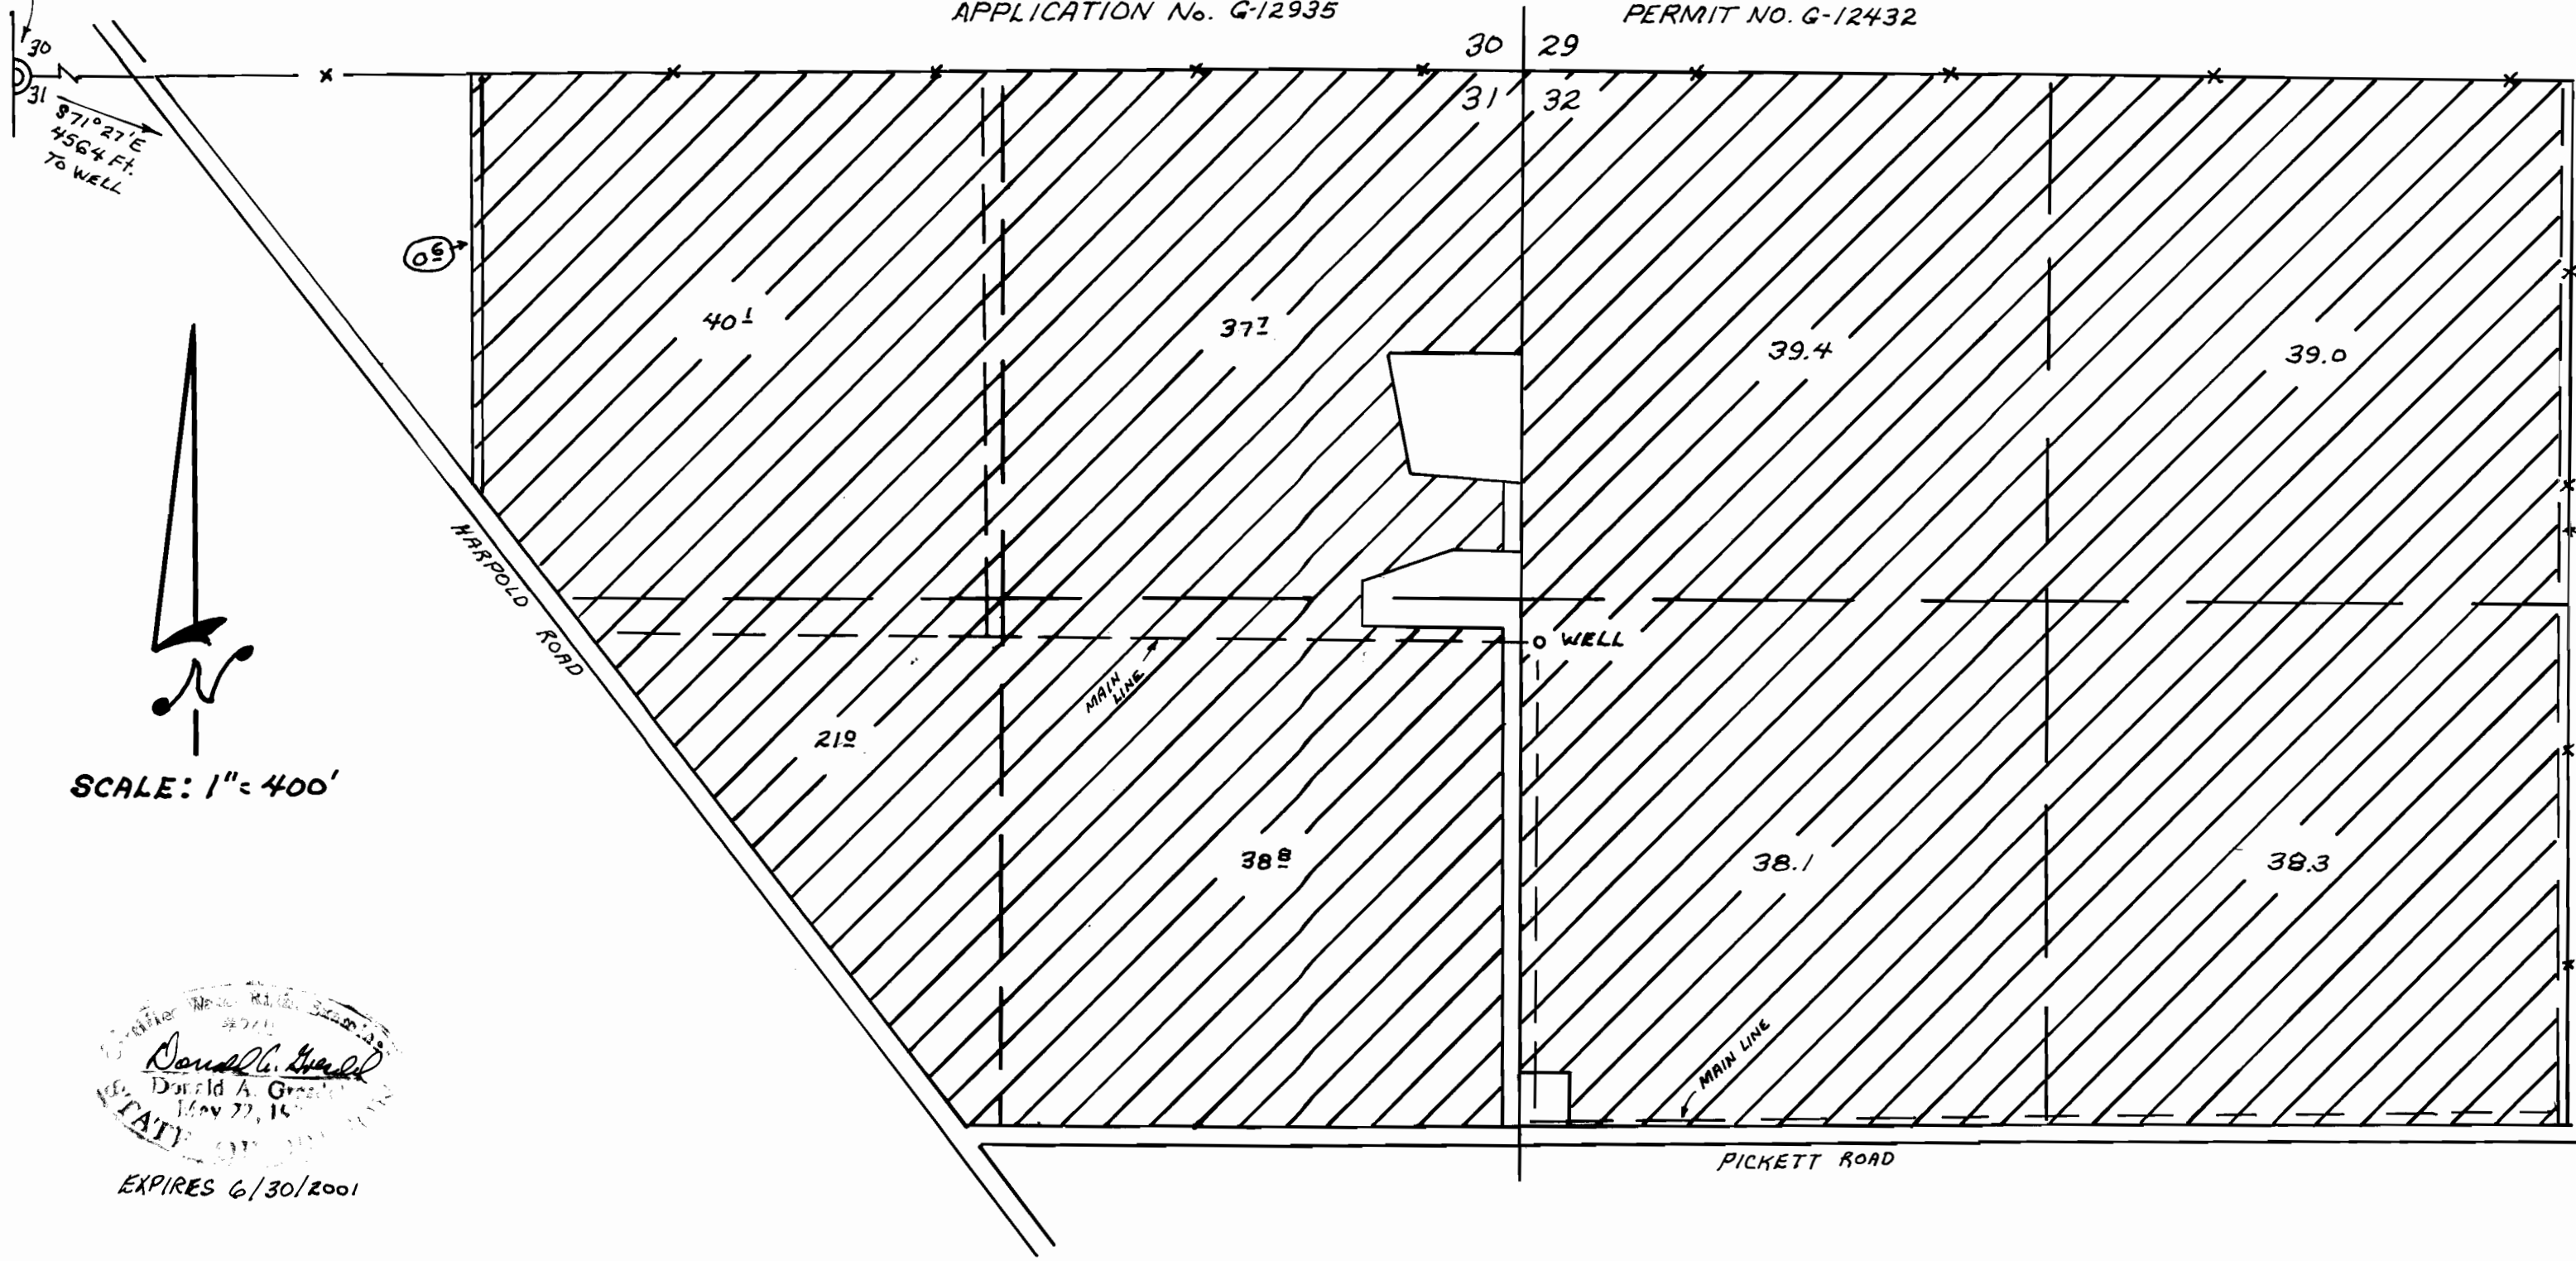

SCALE: 1" = 400'

 Donald A. Green
 May 27, 1999

EXPIRES 6/30/2001

THIS MAP HAS BEEN PREPARED TO DEPICT THE WATER RIGHT AND SHOULD NOT BE USED TO DETERMINE PROPERTY LINES.