



# FINAL PROOF SURVEY MAP for G-13013 AND T-7748

## JELD-WEN

Timber & Ranches  
T 37 S R 11 1/2 E, W.M.

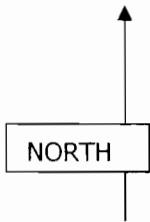


**JAN 8 1 2007**

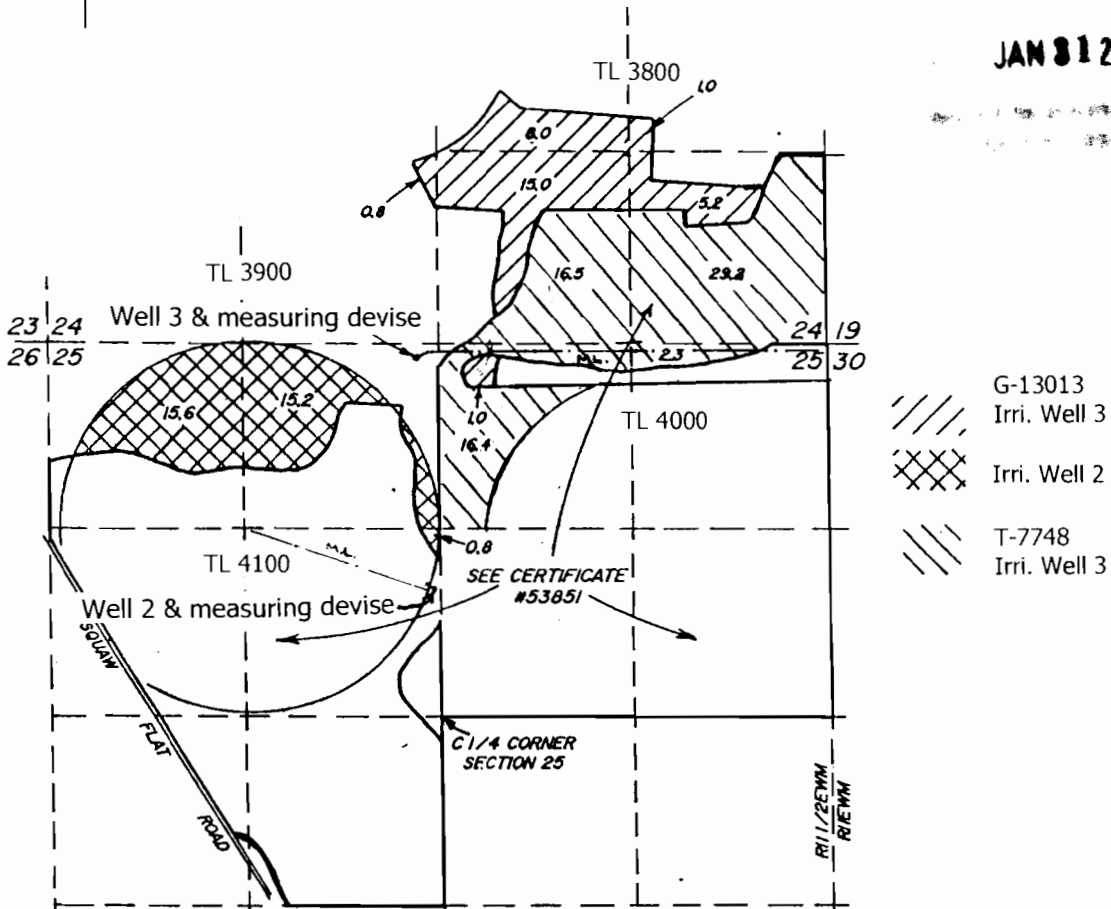

Well 2: 900' N & 50' W from the C 1/4 cor. Sec. 25  
Well 3: 100' S & 2530' E from the NW cor. Sec. 25

Scale 4" = 1 mile

This map is not intended to provide legal dimensions or locations of property ownership lines.

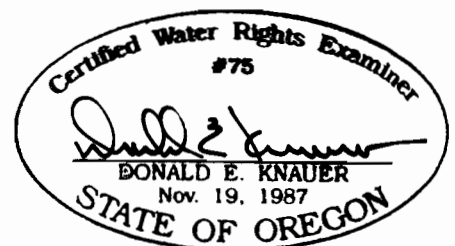

RENEWAL DATE: 6-30-2007