


RECEIVED

JUN 11 1999

WATER RESOURCES DEPT
SALEM OREGON

T.10S. R.4W., W.M

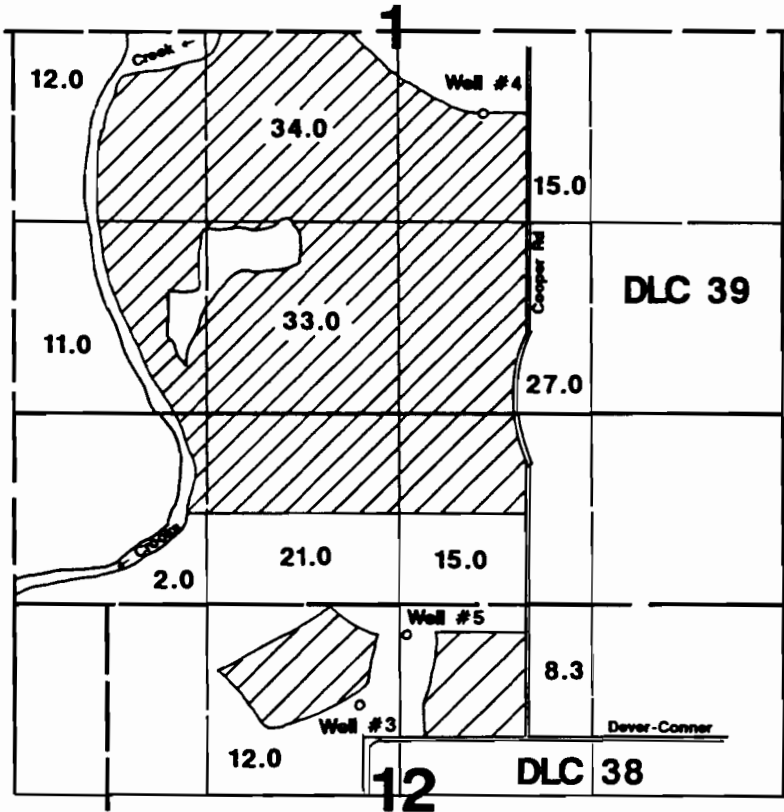

Well # 3 is located 640'N & 250'W from the center of Section 12.
 Well # 4 is located 550'S & 600'E from the center of Section 1.
 Well # 5 is located 1030'N & 20'E from the center of Section 12.

Final Proof Survey

Application #: G-12312 Permit #: G-12470

In Name Of

Marceil Howells & Burnel Harnisch

Surveyed on May 28, 1999 by JM Schuette

This Map Was Prepared For The Purpose Of Identifying The Location Of A Water Right Only And Is Not Intended To Provide Legal Dimensions Or Location Of Property Ownership Lines.

