

RECEIVED

DEC 10 1992

DEC - 3 1992

WATER RESOURCES DEPT.
SALEM, OREGON

WATER RESOURCES DEPT.
SALEM, OREGON

WATER RIGHT APPLICATION MAP

LOCATED IN:


SW 1/4, NE 1/4, T. 37 S., R. 6 W., SEC. 13, W.M.

APPLICANT:
KENNETH D. CLARK
521 TRILLER LANE
GRANTS PASS OR 97527
PHONE: (503) 476-1588

PREPARED BY:
JONATHAN C. SPERO W.R.E. 123
1002 KINCAID RD./P.O. BOX 16
WILLIAMS, OREGON 97544
PHONE (503) 846-6845

APPLICATION NO. G-13211


PERMIT NO. ~~G12347~~ G 12484

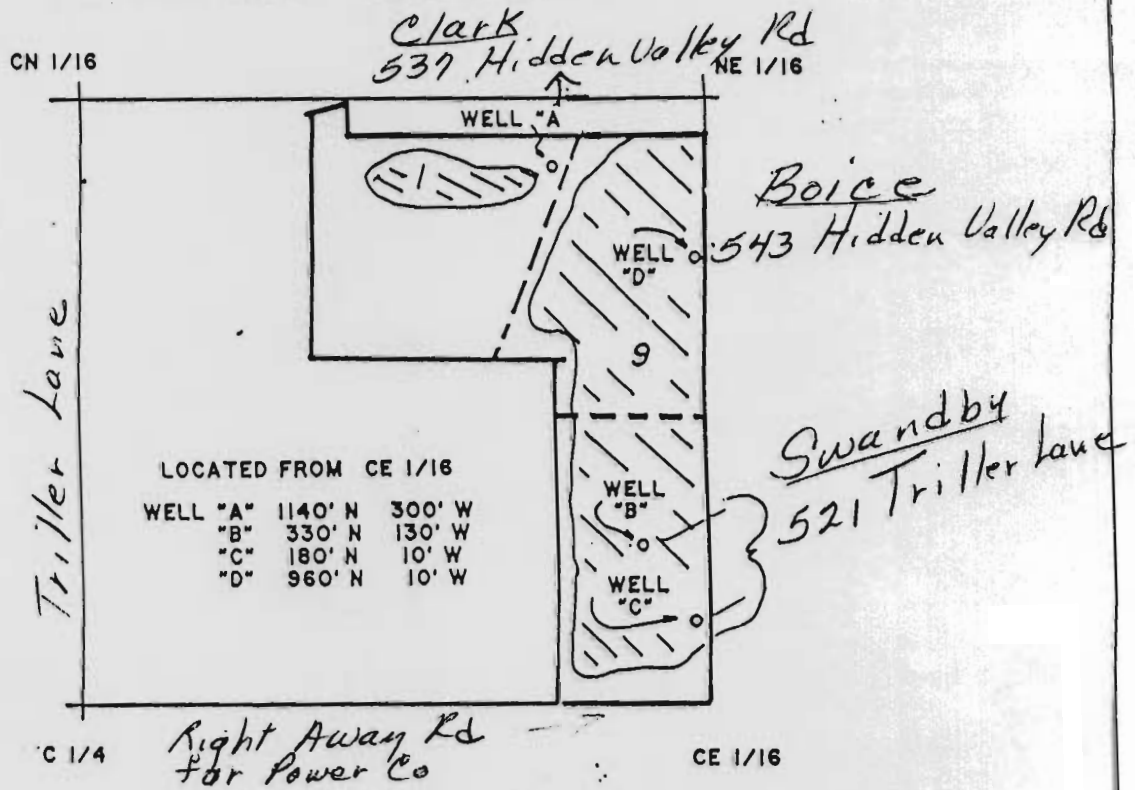

THIS MAP IS FOR THE PURPOSE OF IDENTIFYING THE LOCATION OF THE WATER RIGHT ONLY AND IS NOT INTENDED TO PROVIDE LEGAL DIMENSIONS OR LOCATIONS OF PROPERTY OWNERSHIP LINES.

RECEIVED
APR 25 2003
WATER RESOURCES DEPT
SALEM, OREGON

SCALE: 1" = 400'

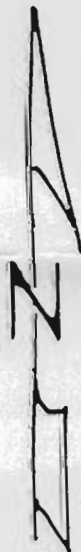

Certified Water Right Examiner
#123 WRE
Jonathan C. Spero
Jonathan C. Spero
Nov. 19, 1987
STATE OF OREGON
EXPIRES 12/31/92