

TOWNSHIP 16 SOUTH,
RANGE 12 EAST, W.M.


Section 19



Scale 1" = 400'

Surveyed Nov. 1, 1997

This map is for the purpose of
locating a water right only
and has no intent to provide
legal dimensions or the location
of property lines.

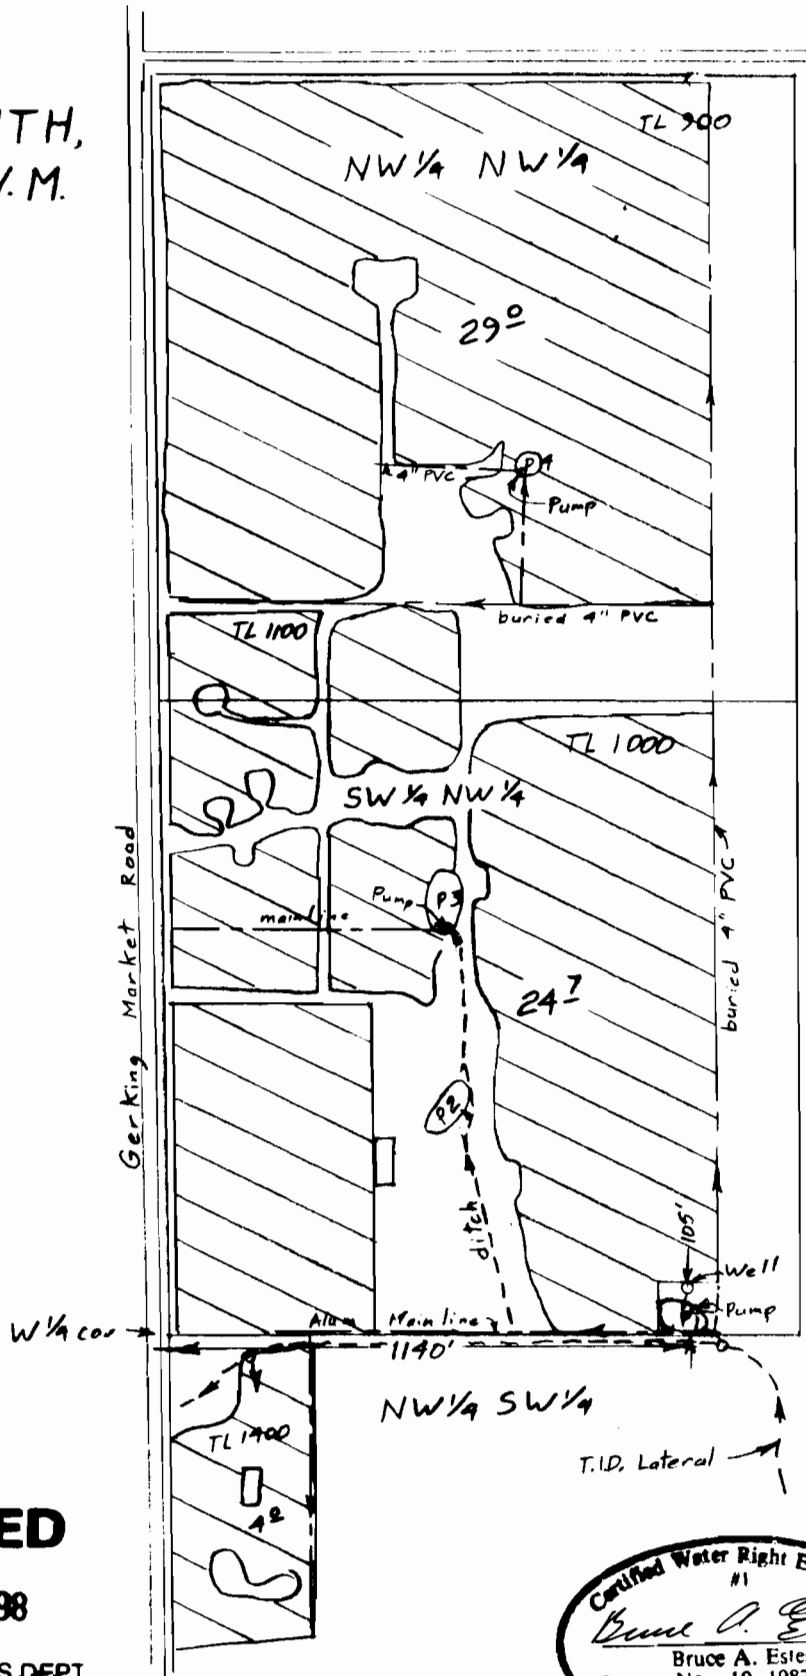


App G-13155
Permit G-12486

RECEIVED

JUL 31 1998

WATER RESOURCES DEPT
SALEM, OREGON

Claim of Beneficial Use Map
for
LLAMA WOODS FARM CO.

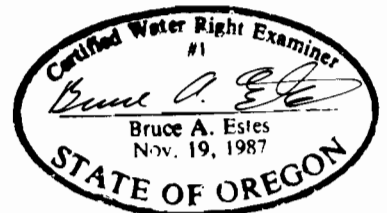

ESTES SURVEYS

6293 Sunnyview Rd. NE 60382 Arnold Rd.
Salem, OR 97305 Bend, OR 97702
(503) 585-7593 (503) 382-7391