


T.13S., R.34E.

15 14
22 23

1/4
COR.

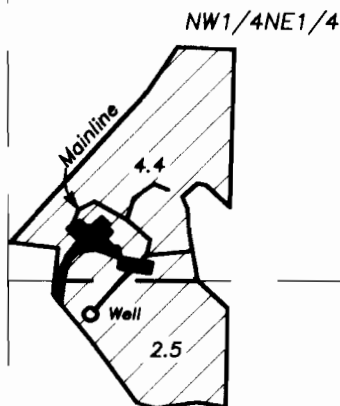

NE1/4NE1/4

SW1/4NE1/4

SE1/4NE1/4

SCALE: 1"=500'

WELL AND POINT OF APPROPRIATION IS 1410' S. AND 210' E. OF THE N1/4 COR.
SEC. 22, T.13S., R.34E.



PLACE OF USE



FOUND 1 1/2" GALV. IRON PIPE WITH ATTACHED
GRANT COUNTY SURVEYOR BRASS CAP

RECEIVED

MAY 23 2002


WATER RESOURCES DEPT.
SALEM, OREGON

FINAL PROOF SURVEY
UNDER

APPLICATION G-13857
PERMIT G-12491

IN NAME OF
SANDY AND MARK MURRAY

SURVEYED MAY 1, 2002 BY ROBERT D. BAGETT

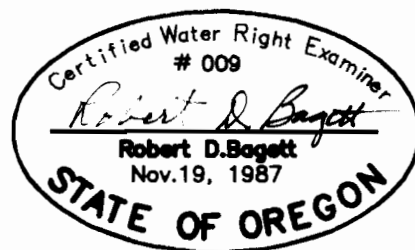

NOTE: The preparation of this map was for the purpose of identifying the location of the proposed water right and has no intent to provide dimensions or location of property ownership lines.