


TOWNSHIPS 16 & 17 SOUTH, RANGE 22 EAST, W.M.

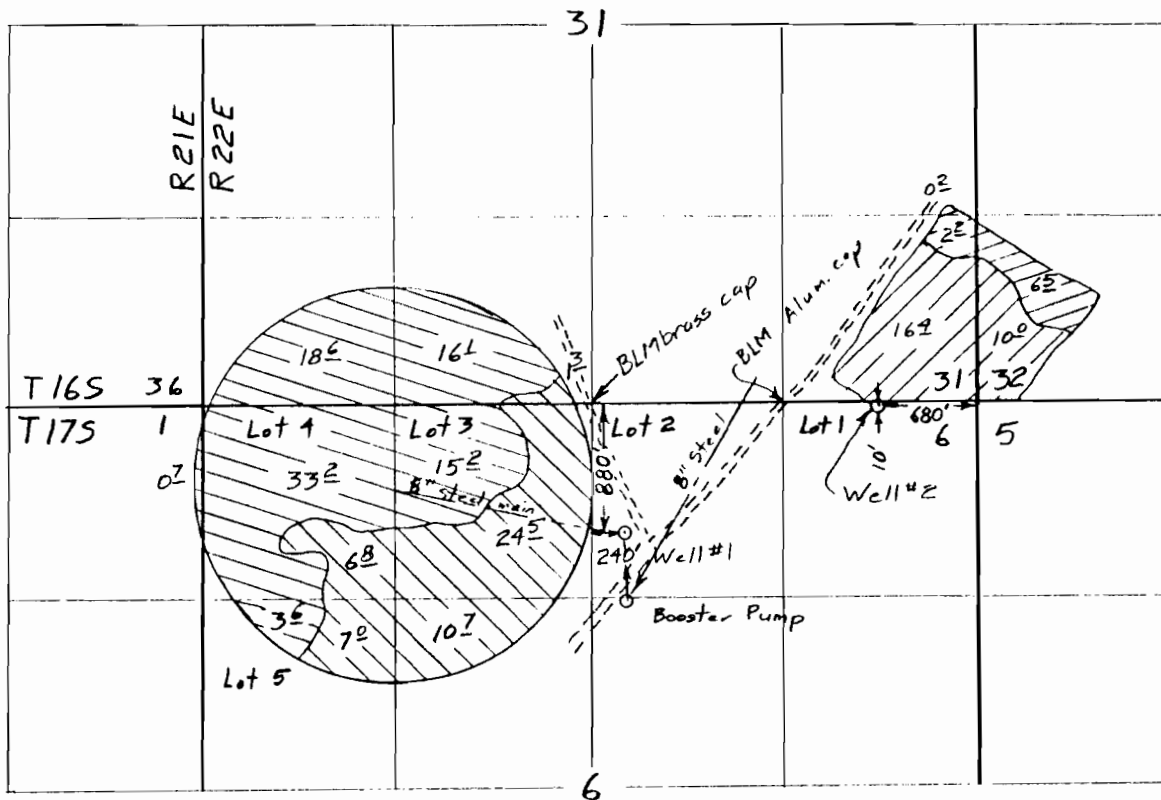

Surveyed Sep. 15, 1999


- ⊗ Well #1 Primary 87 $\frac{1}{2}$ acres
- ⊗ Well #1 Supplemental 50 $\frac{1}{2}$ acres
- ⊗ Well #2 Primary 8 $\frac{1}{2}$ acres
- ⊗ Well #2 Supplemental 26 $\frac{1}{2}$ acres

Scale 1" = 1320'

Claim of Beneficial Use Map
for
GUTIERREZ CATTLE CO.

Application G-13428

Permit G-12498

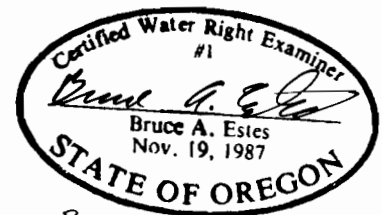

Renewal Dec 31, 2001

This map is for the purpose of locating a water right only and has no intent to provide legal dimensions or the location of property lines.

ESTES SURVEYS

PO Box 17519
Salem, OR 97305-7519
(503) 585-7593

60382 Arnold Rd
Bend, OR 97702
(541) 382-7391