


TOWNSHIP 9 SOUTH, RANGE 14 EAST, W.M.

Section 27

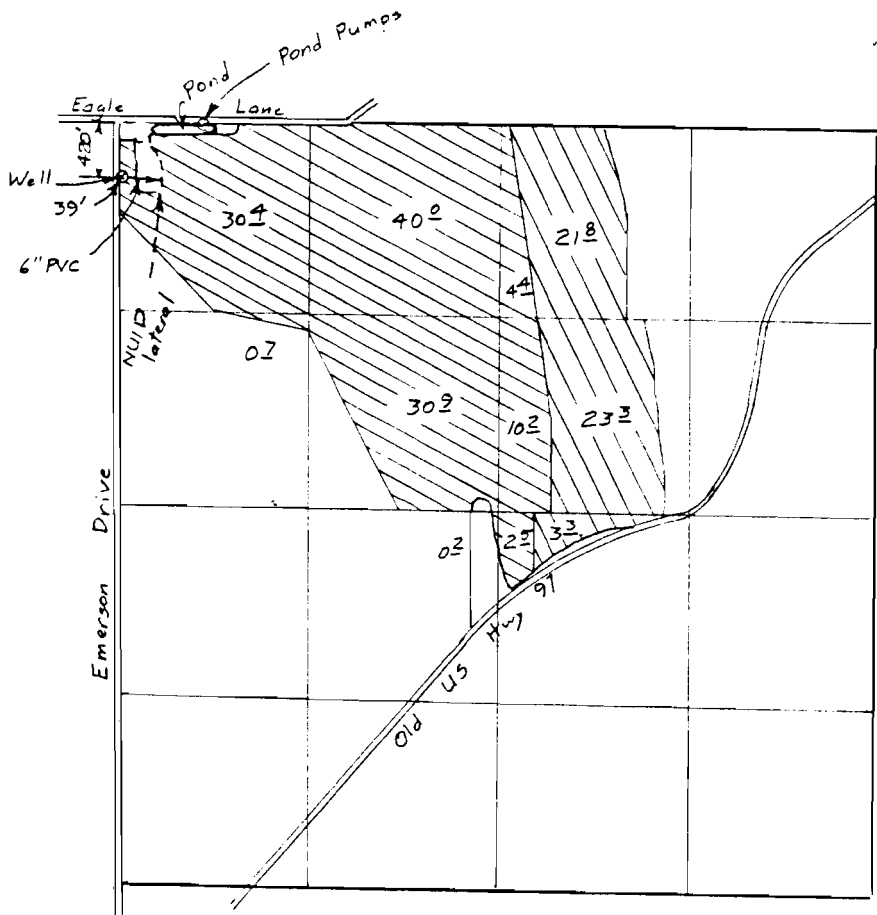


Scale 1" = 1320'

Surveyed Sep 1, 2000

- ⊗ Supplemental to C- 51231 (Deschutes River)
- ⊗ Supplemental to C- 51233 (Crooked River)

App G-13145
Per G-12509

Claim of Beneficial Use Map
for
ENOS R. & JANICE R. BROWN

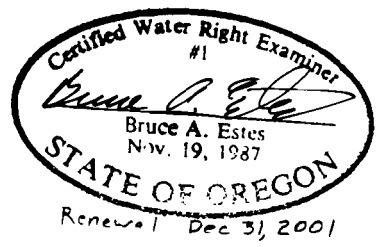

This map is for the purpose of locating a water right only and has no intent to provide legal dimensions or the location of property lines.

ESTES SURVEYS

PO Box 17519 60382 Arnold Rd
Salem, OR 97305-7519 Bend, OR 97702
(503) 585-7593 (541) 382-7391