

CLAIM OF BENEFICIAL USE

APPLICATION No. G-13638

PERMIT No. G-12514





Well in Malheur River Basin

Applicant: Laurence B. Winebarger
3639 Arabian Drive
Ontario, OR 97914

Scale 1"=400'

T18S R46E
Tax Lot #18 46 C 6200

1/4

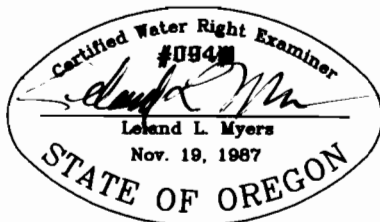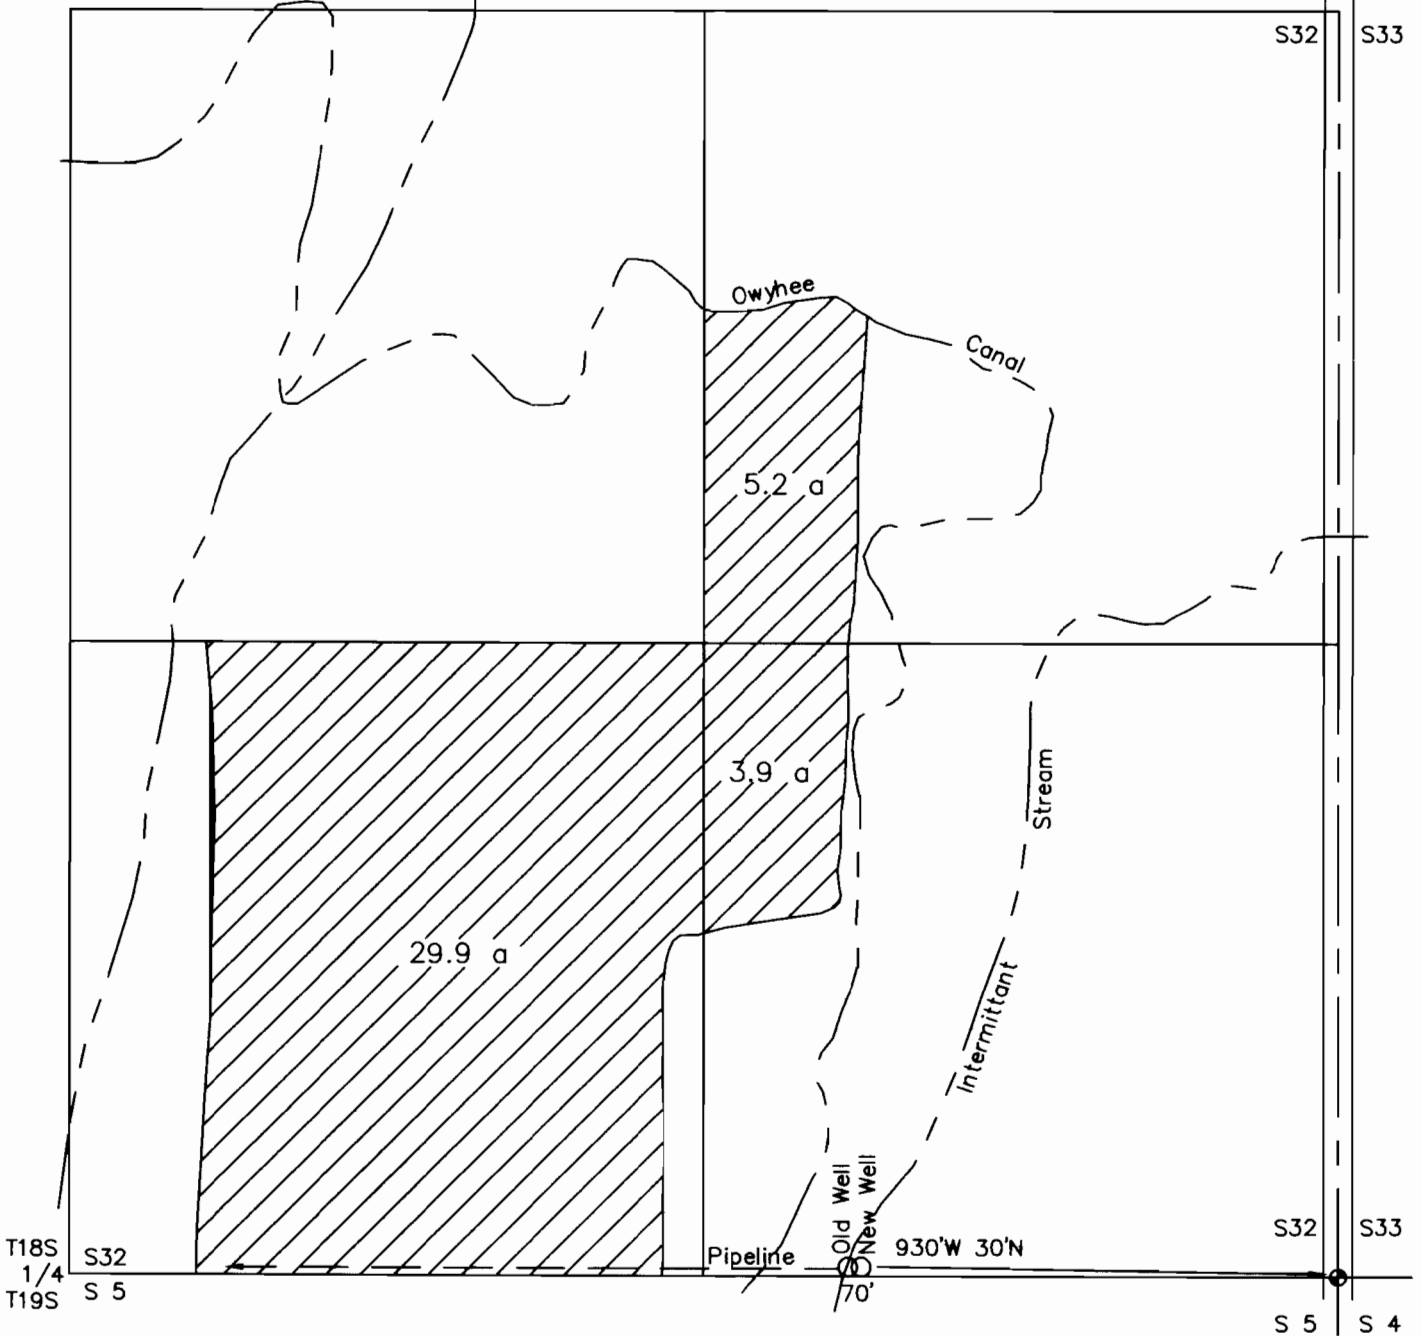

This map is for the purpose of identifying the location of the water right only and has no intent to provide dimensions or location of property ownership lines.